


ELECTRICAL SCHEDULE CONFIRM ALL SELECTIONS WITH OWNER				ELECTRICAL LEGEND			
MARK	DESCRIPTION	MANUFACTURER/TYPE	MODEL NUMBER	- 0	DUPLEX OUTLET	<b>-</b>	CEILING LIGHT FIXTURE
А	2" RECESSED CAN (WET LISTED)	ELITE ROUND LED RL271, WHITE TRIM	RL271-600-XX-90-SHZ-WH (WET LISTED)	]	220V OUTLET	Ι Υ	CEIEINO EIGITI TIXTORE
В	4" RECESSED CAN (WET LISTED)	ELITE LED RETROFIT DIE-CAST ALUMINUM LENSED BAFFLE RL431, WHITE	RL431-650L-DIMT-120-XX-90-W-WH (WL)	] ₩	4 PRONG OUTLET	+	WALL LIGHT FIXTURE
С	3" SLOPED CEILING CAN	ELITE RECESSED GIMBAL SLIM LED RL373, WHITE	RL373-600L-DIMTR-120-XX-90-XX-XX	"	FLOOR OUTLET		FLOOD LIGHTS
D	6" SLOPED CEILING CAN	ELITE LED ADJUSTABILITY SLOPED CEILING BAFFLE RL694, WHITE	RL694-1000L-DIMTR-MVOLT-XX-90-W-WH		HALF SWITCHED OUTLET		FLOOD LIGHTS
Е	6" SLOPED CEILING CAN (WET LOCATION)	ELITE LED ADJUSTABILITY SLOPED CEILING BAFFLE RL694, PLASTIC LENS	RL694-1000L-DIMTR-MVOLT-XX-90-W-WH (WL)	] Ψ	SWITCH		FAN/FAN LIGHT
F	STANDARD CLOSET LIGHT	ELITE EU-LED UNDERCABINET SERIES	EU-LED-18-600L-DIMTR-XX-WH	<b>7</b>	TV CABLE		THIV/THIN LIGHT
G	STANDARD GARAGE LIGHT	ORACLE BY ELITE, ARCHITECTURAL LED SURFACE/SUSPENDED LINEAR-DIRECT OC1-LED 4'	4-OC1-LED-4000L-DIM10-MVOLT-XX-85		PHONE	<u>                                   </u>	⇒ IN-JAMB SWITCH
Н	UNDERCABINET LIGHTING	PRECISE LUMAMATE MINI	LMMT-MN-XX-90-24V-30K		THERMOSTAT	J	JUNCTION BOX
J	PUCK LIGHT	ELITE LED PORTABLE CABINET LIGHT	LED-HU22-3-130L-30K-XX				
K	SINGLE FLOOD LIGHT	ELITE LED ARCHITECTURAL SMALL FL SERIES, BUILDING MOUNT W/ 1/2" KO CANOPY BY EC	OFL-101-LED-XXX-DIM10-MVOLT-XX-BZ	$\frac{1}{4}$	GAS CONNECTION		CARBON MONOXIDE DETECTOR
L	DECORATIVE FIXTURE	TBD			WALL VACUUM OUTLET	<b>(D)</b>	SMOKE ALARM
Т	PORCELAIN BULB HOLDER	ELECTRICIAN'S CHOICE					
Z	EXISTING FIXTURE			1			

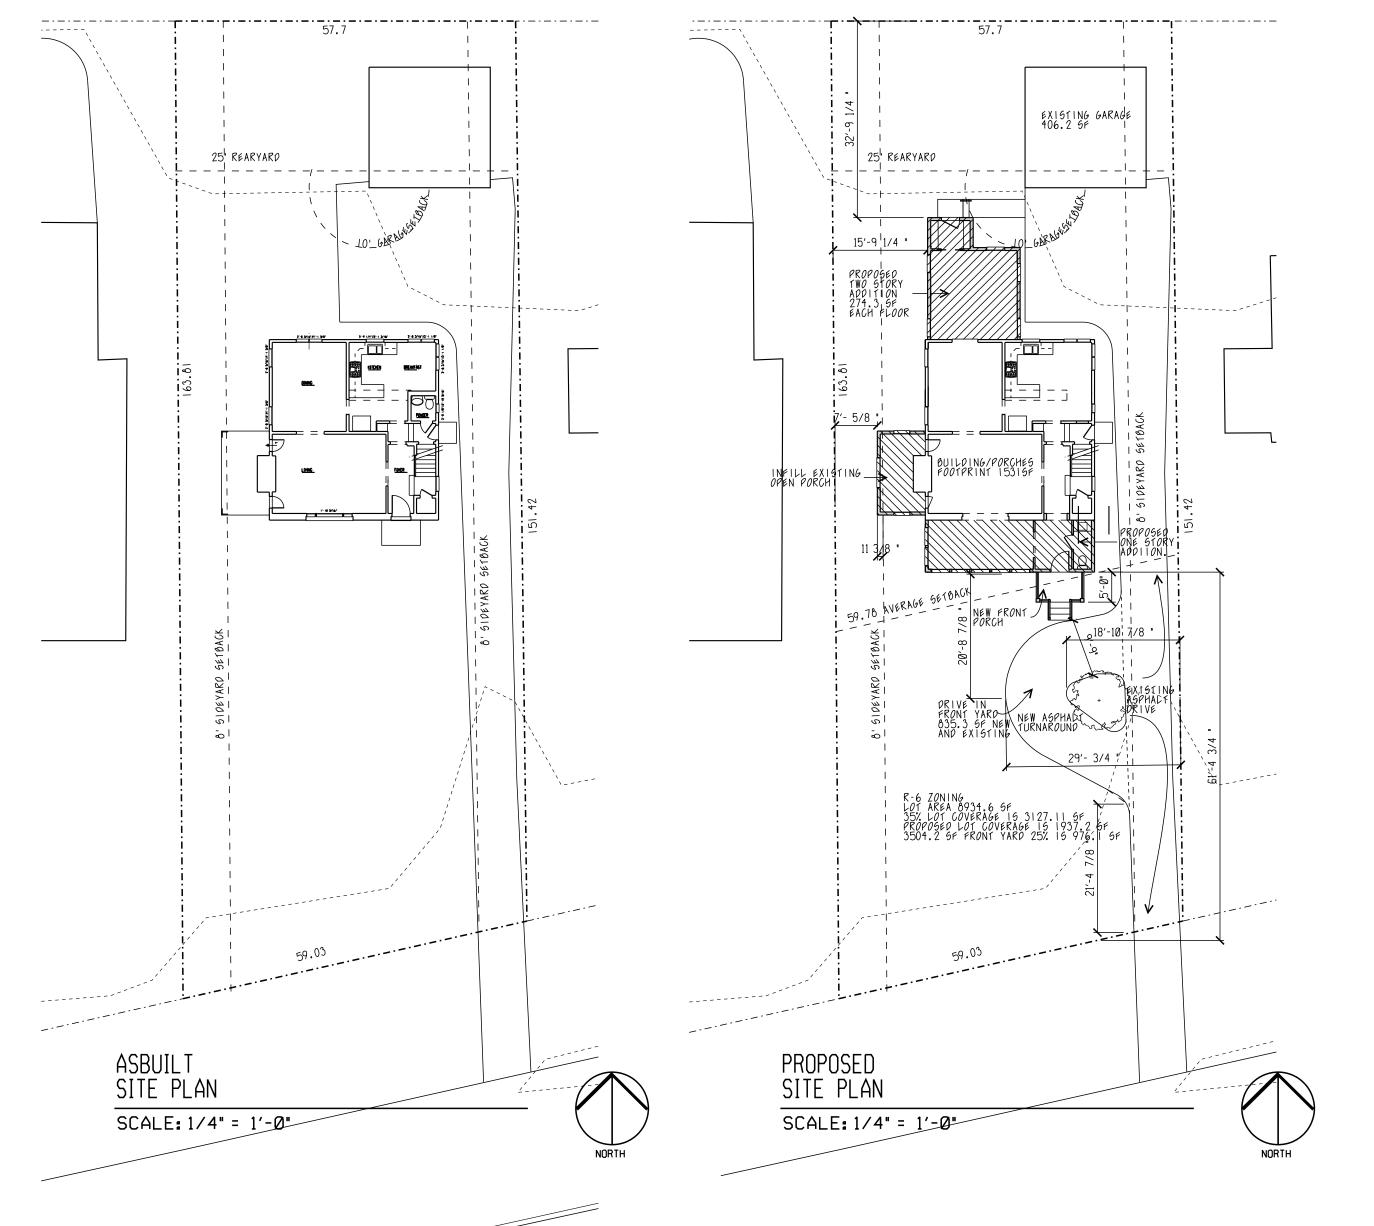

# JULIET BULLOCK ARCHITECTS 4886 OLENTANGY BLVD COLUMBUS OH 43214 614-935-0944

# INDEX TO DRAWINGS

SHEET 1 SITE PLAN

SHEET 2 ASBUILT FIRST FLOOR PLAN ASBUILT SECOND FLOOR PLAN

SHEET 3 FOUNDATION PLAN

SHEET 4 PROPOSED FIRST FLOOR PLAN/MEP

SHEET 5 PROPOSED SECOND FLOOR PLAN/MEP

SHEET 6 EXTERIOR ELEVATIONS

SHEET 7 SECTION

SHEET 8 SECTION

SHEET 9 S-1 STRUCTURAL

### BUILDING CODE INFORMATION

TWO STORY ADDITION TO THE REAR 273.5 SF EACH FLOOR ONE STORY ADDITION TO THE FRONT 244.4 SF INFILL EXISTING COVERED PORCH 99.8 SF NEW FRONT PORCH 40 SF NEW TURN-AROUND DRIVE

DO NOT SCALE THE DRAWINGS AS THE PRINTING PROCESS

### ZONING INFORMATION

PARCEL NO. 020-002375-00

# **GENERAL NOTES**

CAN DISTORT THE DRAWINGS. THE CONTRACTOR IS RESPONSIBLE TO CHECK AND VERIFY ALL DIMENSIONS AND SITE CONDITIONS AND NOTIFY THE ARCHITECT OF ANY ERRORS/OMISSIONS PRIOR TO THE START OF CONSTRUCTION. THE ARCHITECTS IS RESPONSIBLE FOR ONLY THOSE ITEMS SHOWN ON THE DRAWINGS. THE GENERAL CONTRACTOR IS TO CONFORM TO ALL APPLICABLE CODES, ORDINANCES AND APPROVED CONSTRUCTION PRACTICES FOR ALL ITEMS NOT DETAILED OR OTHERWISE INDICATED. THE GENERAL CONTRACTOR IS RESPONSIBLE FOR THE DESIGN AND INSTALLATION OF ALL PLUMBING, HVAC AND ELECTRICAL SYSTEMS. THESE SYSTEMS SHALL BE DESIGNED AND INSTALLED IN CONFORMANCE WITH ALL APPLICABLE CODE REQUIREMENTS AND ACCEPTABLE ENGINEERING PRACTICES. NO WORKS SHALL COMMENCE UNTIL THE UTILITY COMPANIES HAVE LOCATED AND MARKED UNDERGROUND UTILITIES AND THAT MAY POTENTIALLY BE A HAZARD. ALL ROOF WATER FROM ANY BUILDING SHALL BE CARRIED FROM DOWNSPOUTS TO THE STREET GUTTER OR STORM SEWER AS APPLICABLE THROUGH THIN WALLED PVC CORRUGATED ADS OR OTHER APPROVED EQUIVALENT HAVING MINIMUM DIAMETER OF 4" BEDDED IN SAND AND LAID TO PROPER GRADE.

#### **GENERAL PLAN NOTES**

AREA COMMISSION AS APPLICABLE.

VERIFY INTERIOR FINISHES WITH THE OWNER, INCLUDING FLOOR COVERINGSCABINETRY, FIXTURES, DOORS AND TRIM. CONFIRM TRIM SPECIFICATIONS WITH OWNER. ELEVATIONS ON FLOOR PLANS ARE FOR GENERAL REFERENCE ONLY. NEW FINISH SECOND FLOOR TO ALIGN WITH EXISTING. FIELD VERIFY EXACT HEIGHT. CONTRACTOR TO VERIFY ALL WINDOWS MEET ALL LOCAL SAFETY AND EGRESS CODES. NEW FLOOR FRAMING TO BE DESIGNED FOR 40 PSF LIVE LOAD. ROOF

ANY EXTERIOR MODIFICATIONS TO THE PLANS AS DRAWN

ARE TO BE REVIEW AND APPROVED BY THE APPROPRIATE

FRAMING DESIGNED FOR 25 PSF.
PROVIDE SOUND BATT AT ALL BATHROOM AND LAUNDRY WALLS AND

FLOORS.

VERIFY ALL CLOSET INTERIOR REQUIREMENTS WITH OWNERS FOR BLOCKING AND LOCATIONS OF SPECIFIC WALL HUNG STORAGE

BLOCKING AND LOCATIONS OF SPECIFIC WALL HUNG STORAGE.

20-AMPERE BRANCH CIRCUITS SUPPLYING OUTLETS INSTALLED IN

DWELLING UNIT FAMILY ROOMS, DINING ROOMS, LIVING ROOMS, PARLORS, LIBRARIES, DENS, BEDROOMS, SUNROOMS, RECREATION ROOMS, CLOSETS, HALLWAYS, OR SIMILAR ROOMS OR AREAS SHALL BE PROTECTED BY A LISTED ARC-FAULT CIRCUIT INTERRUPTER, COMBINATION-TYPE, INSTALLED TO PROVIDE PROTECTION OF THE BRANCH CIRCUIT.

CHILD PROOF RECEPTACLES ARE TO BE PROVIDED AS REQUIRED BY CODE.

2832 EAST BROAD STREET BEXLEY OHIO

2/10/25

SHEET 1