


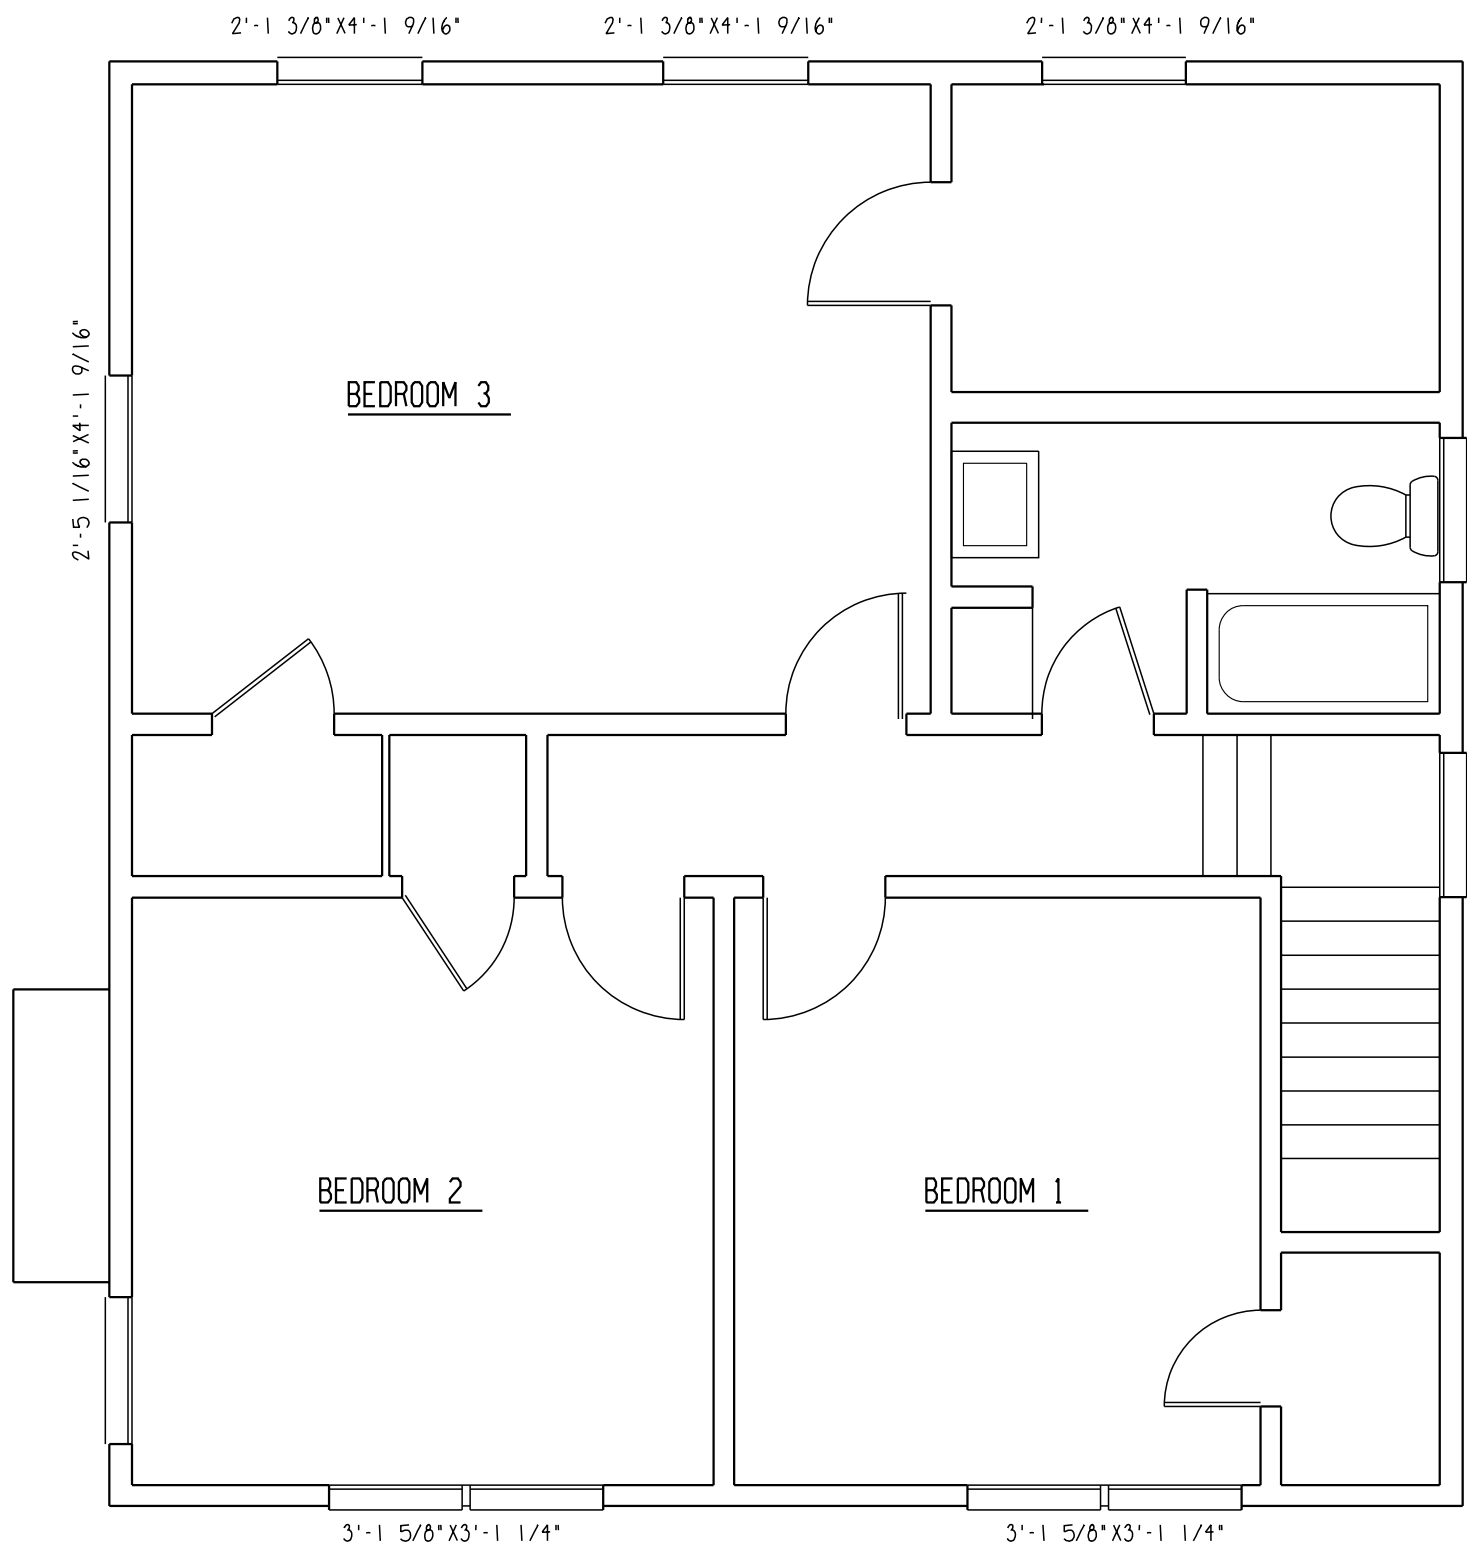


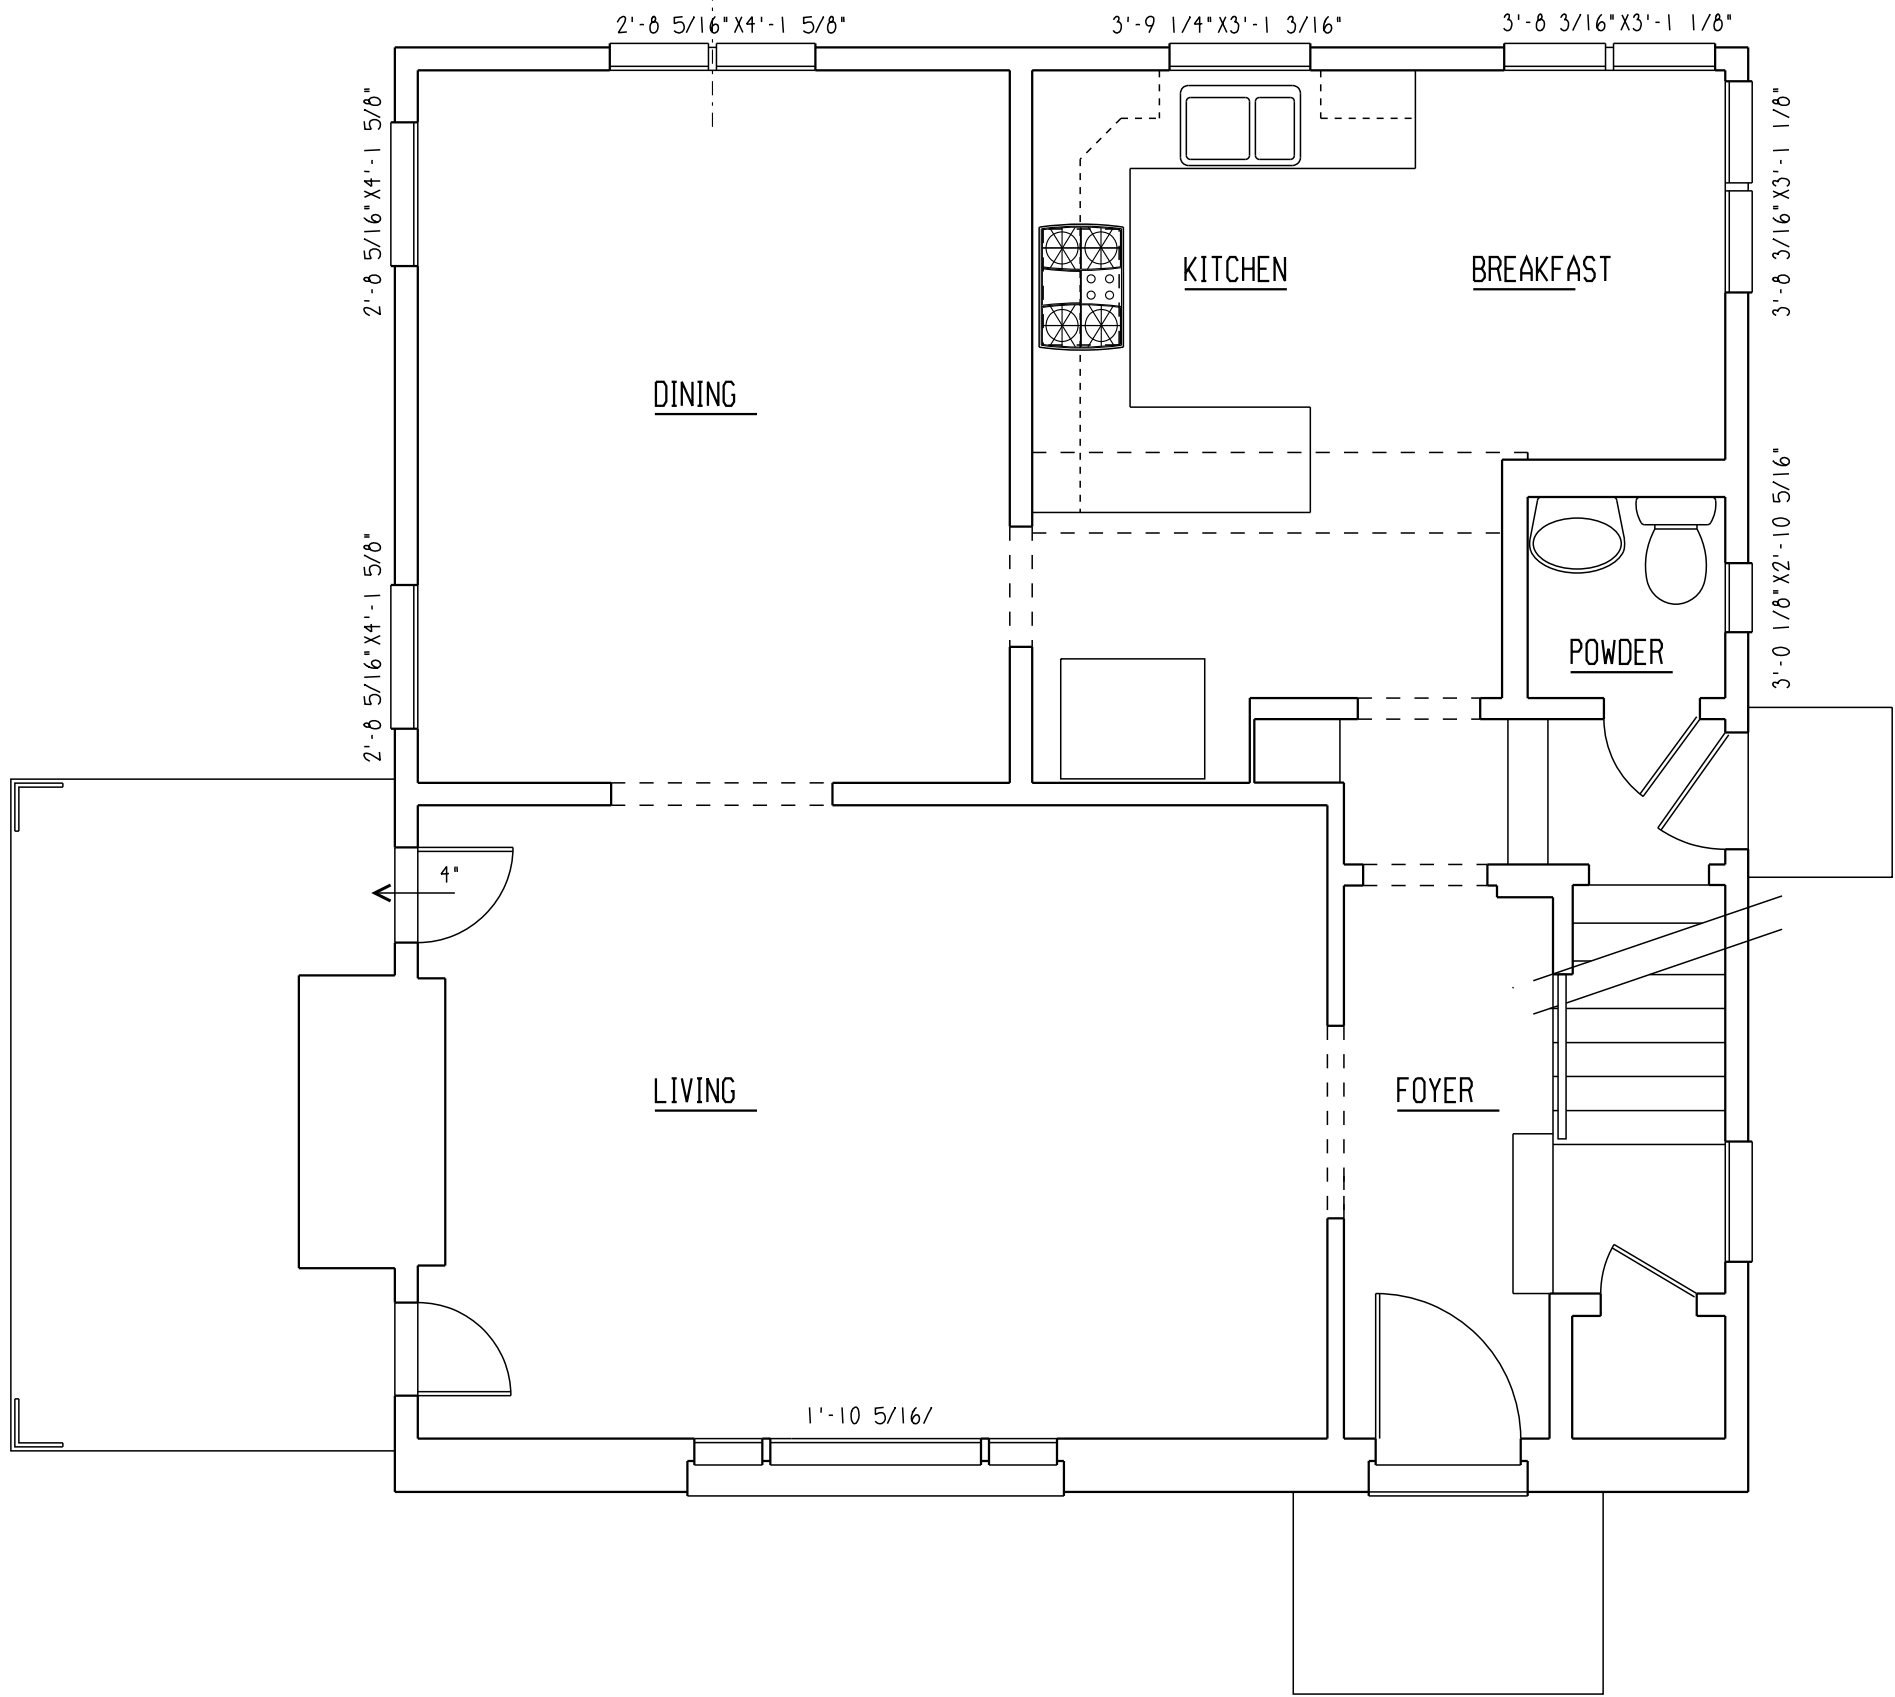

ASBUILT
SECOND FLOOR PLAN
SCALE: 1/4" = 1'-0"

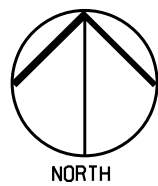

ASBUILT
FIRST FLOOR PLAN
SCALE: 1/4" = 1'-0"

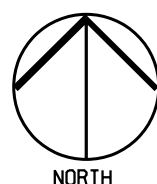

2/10/25

2832 EAST BROAD STREET
BEXLEY OHIO

SHEET 2