



# WALKER-PEACOCK PROJECT 2021



DRAWINGS PROVIDED BY:

THE CLEARY COMPANY  
989 Old Henderson Rd  
COLUMBUS, OH 43220  
614.459.4000

**WALKER-PEACOCK RESIDENCE**  
2299 COMMONWEALTH PARK S - BEXLEY, OHIO 43209

**COVER SHEET**



REVISIONS

| NO. | DATE |
|-----|------|
|     |      |
|     |      |

ISSUE DATE:  
2/10/2021

PROJECT #2299-C-20

SCALE:  
NA

SHEET NO.  
**C**

COMMONWEALTH PARK S. 40'

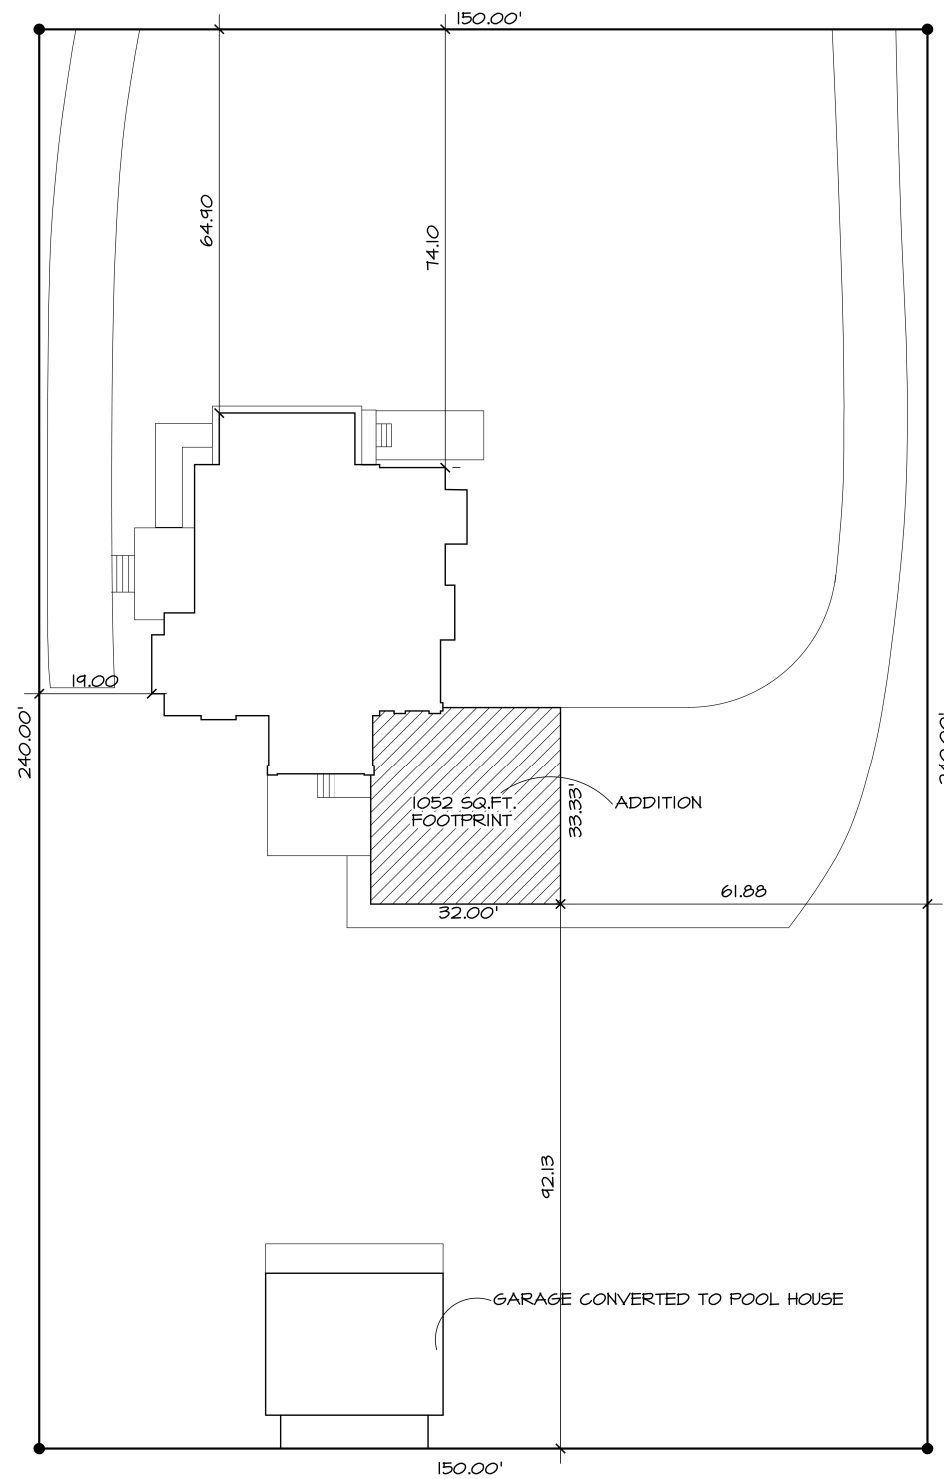

**ZONING INFO:**

PARCEL ID 020-002112  
 R-2 Intermediate Density Residential  
 TOTAL LOT SQ.FT. 36,000 SQ.FT.  
 BUILDING COVERAGE 4386 SQ.FT. 12%  
 PAVING COVERAGE 5081 SQ.FT. 14%  
 TOTAL LOT COVERAGE = 9467 SQ.FT. 26%



EXISTING HOME



AREAS OF NEW ADDITION

**SITE PLAN**  
 SCALE: 1"=20'-0"



Copyright © 2021 The Cleary Company. Concepts and drawings contained herein remain the property of The Cleary Company and may not be reproduced or translated without the written permission of a The Cleary Company representative.



DRAWINGS PROVIDED BY:

THE CLEARY COMPANY  
 989 Old Henderson Rd  
 COLUMBUS, OH 43220  
 614.459.4000

**WALKER-PEACOCK RESIDENCE**  
 2299 COMMONWEALTH PARK S - BEXLEY, OHIO 43209

**SITE PLAN**

REVISIONS

| NO. | DATE |
|-----|------|
|     |      |
|     |      |

ISSUE DATE:  
 2/10/2021

PROJECT #2299-C-20

SCALE:  
 NA

SHEET NO.

**1**

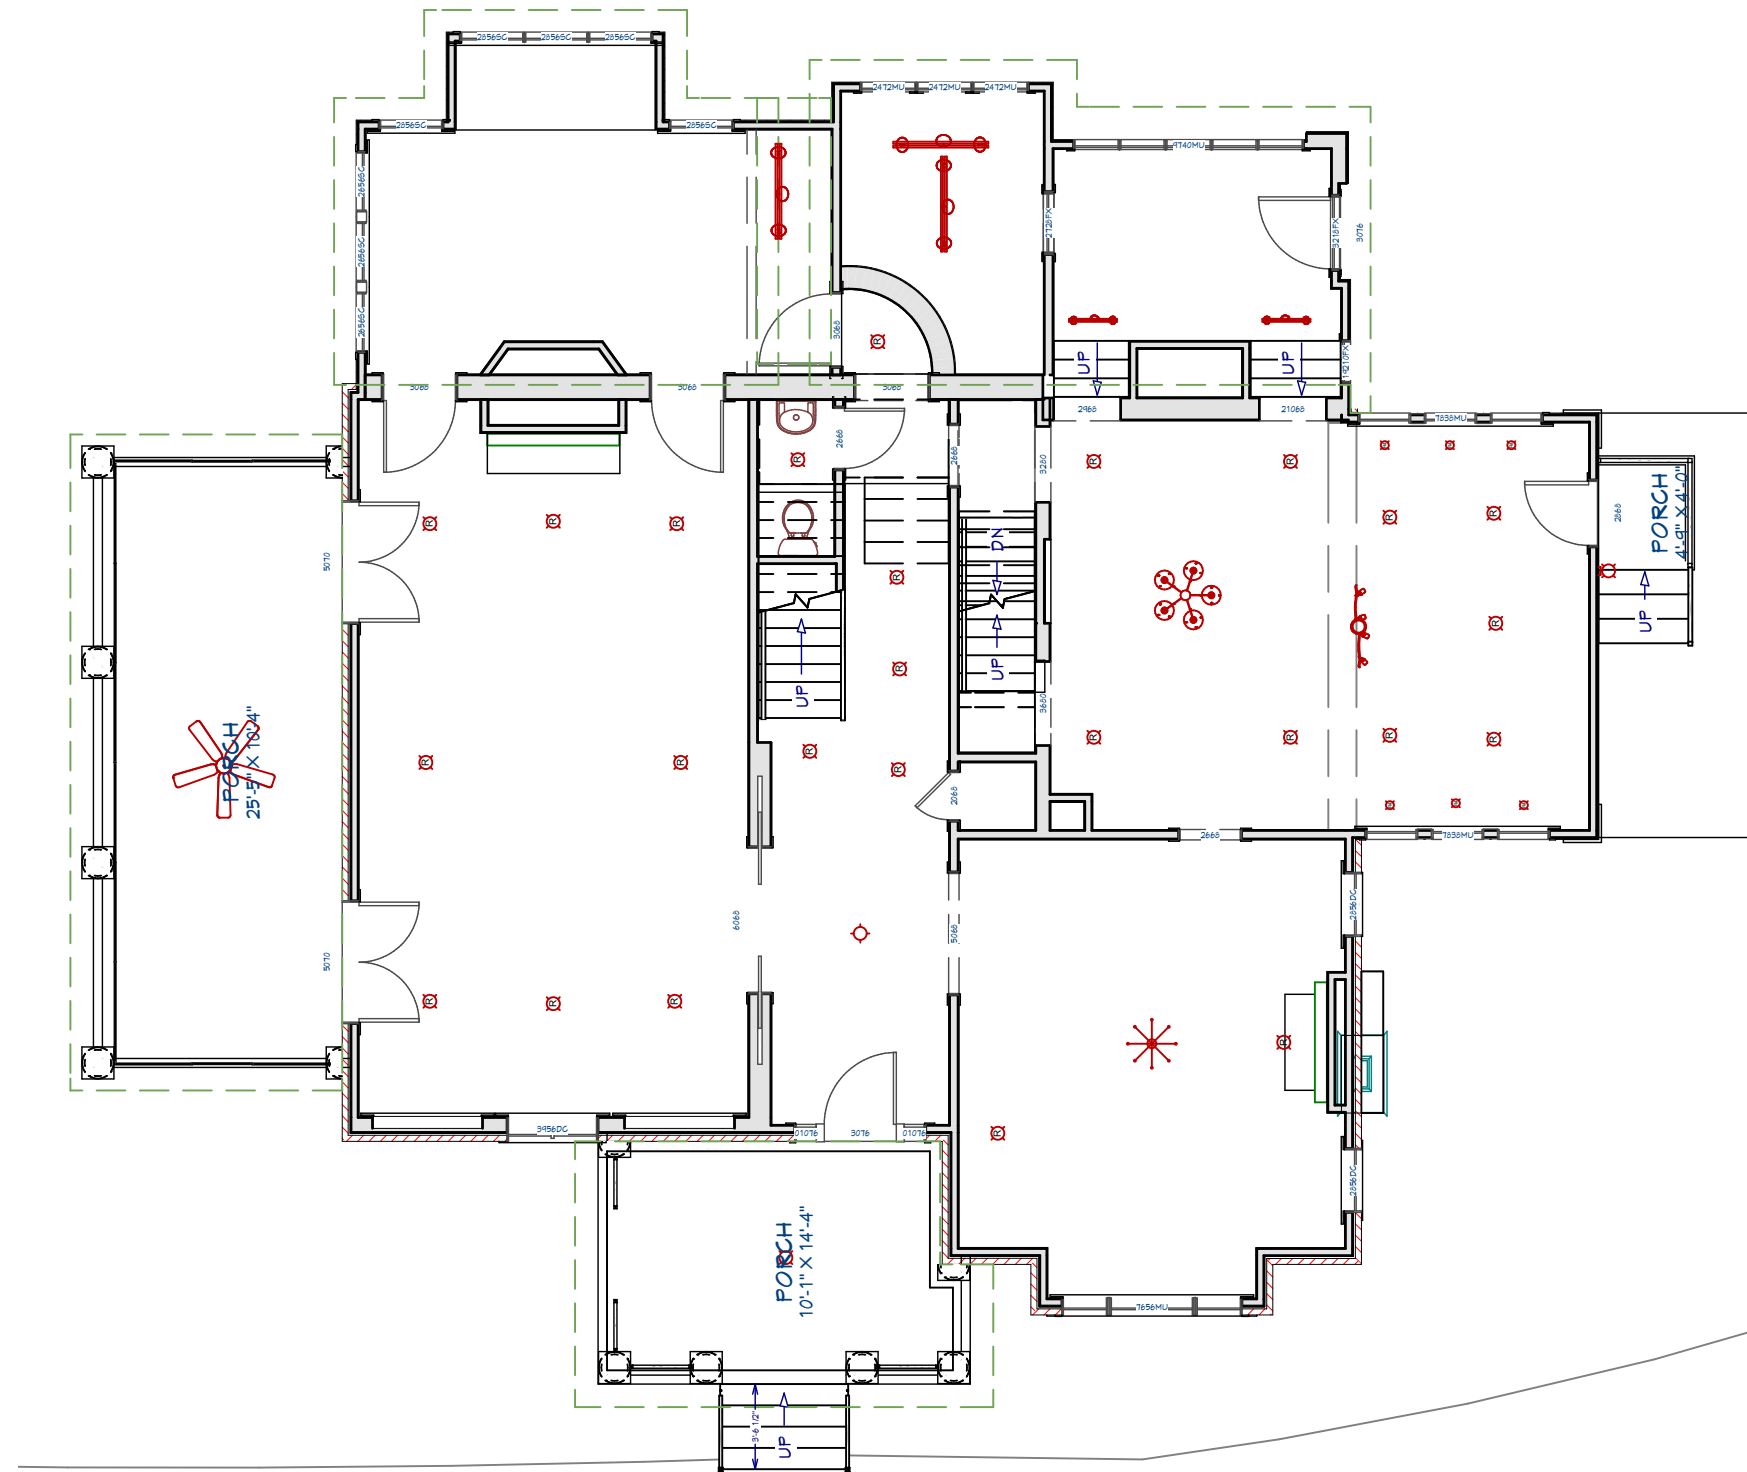

FIRST FLOOR

Copyright © 2021 The Cleary Company.  
 Concepts and drawings contained herein  
 remain the property of The Cleary Company  
 and may not be reproduced or translated  
 without the written permission of a The Cleary  
 Company representative.



DRAWINGS PROVIDED BY:

THE CLEARY COMPANY  
 989 Old Henderson Rd  
 COLUMBUS, OH 43220  
 614.459.4000

**WALKER-PEACOCK RESIDENCE**  
 2299 COMMONWEALTH PARK S - BEXLEY, OHIO 43209

**AS BUILT FIRST FLOOR**

REVISIONS

| NO. | DATE |
|-----|------|
|     |      |
|     |      |
ISSUE DATE:  
2/10/2021

PROJECT #2299-C-20

SCALE:  
NA

SHEET NO.  
**2**




DRAWINGS PROVIDED BY:

THE CLEARY COMPANY  
989 Old Henderson Rd  
COLUMBUS, OH 43220  
614.459.4000

**WALKER-PEACOCK RESIDENCE**  
2299 COMMONWEALTH PARK S - BEXLEY, OHIO 43209

**AS BUILT SECOND FLOOR**

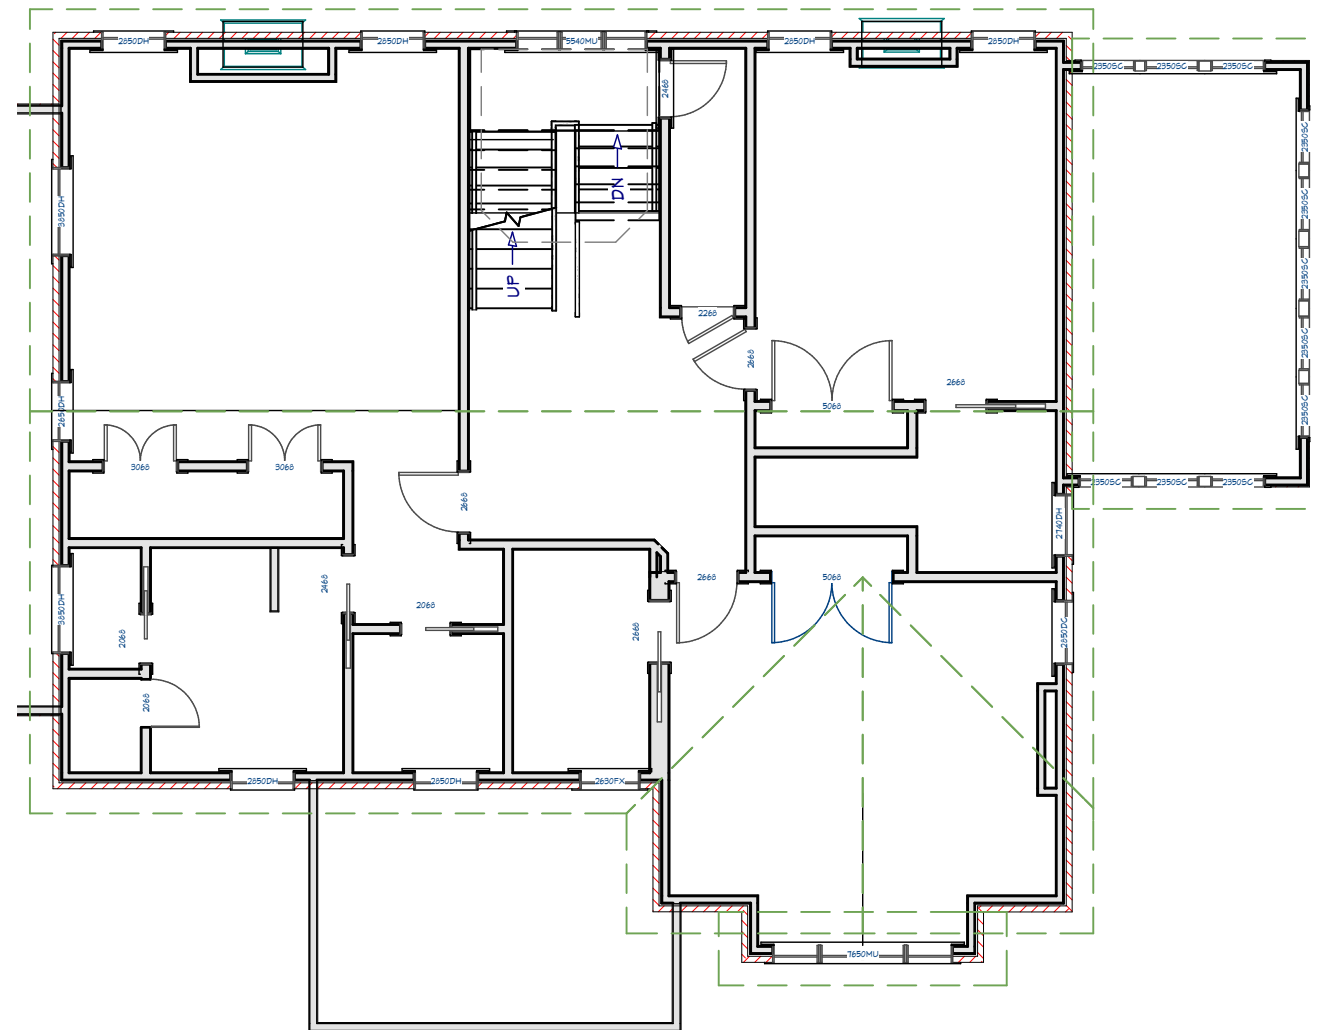

SECOND FLOOR

REVISIONS

| NO. | DATE |
|-----|------|
|     |      |
|     |      |

ISSUE DATE:  
2/10/2021

PROJECT #2299-C-20

SCALE:  
NA

SHEET NO.

3

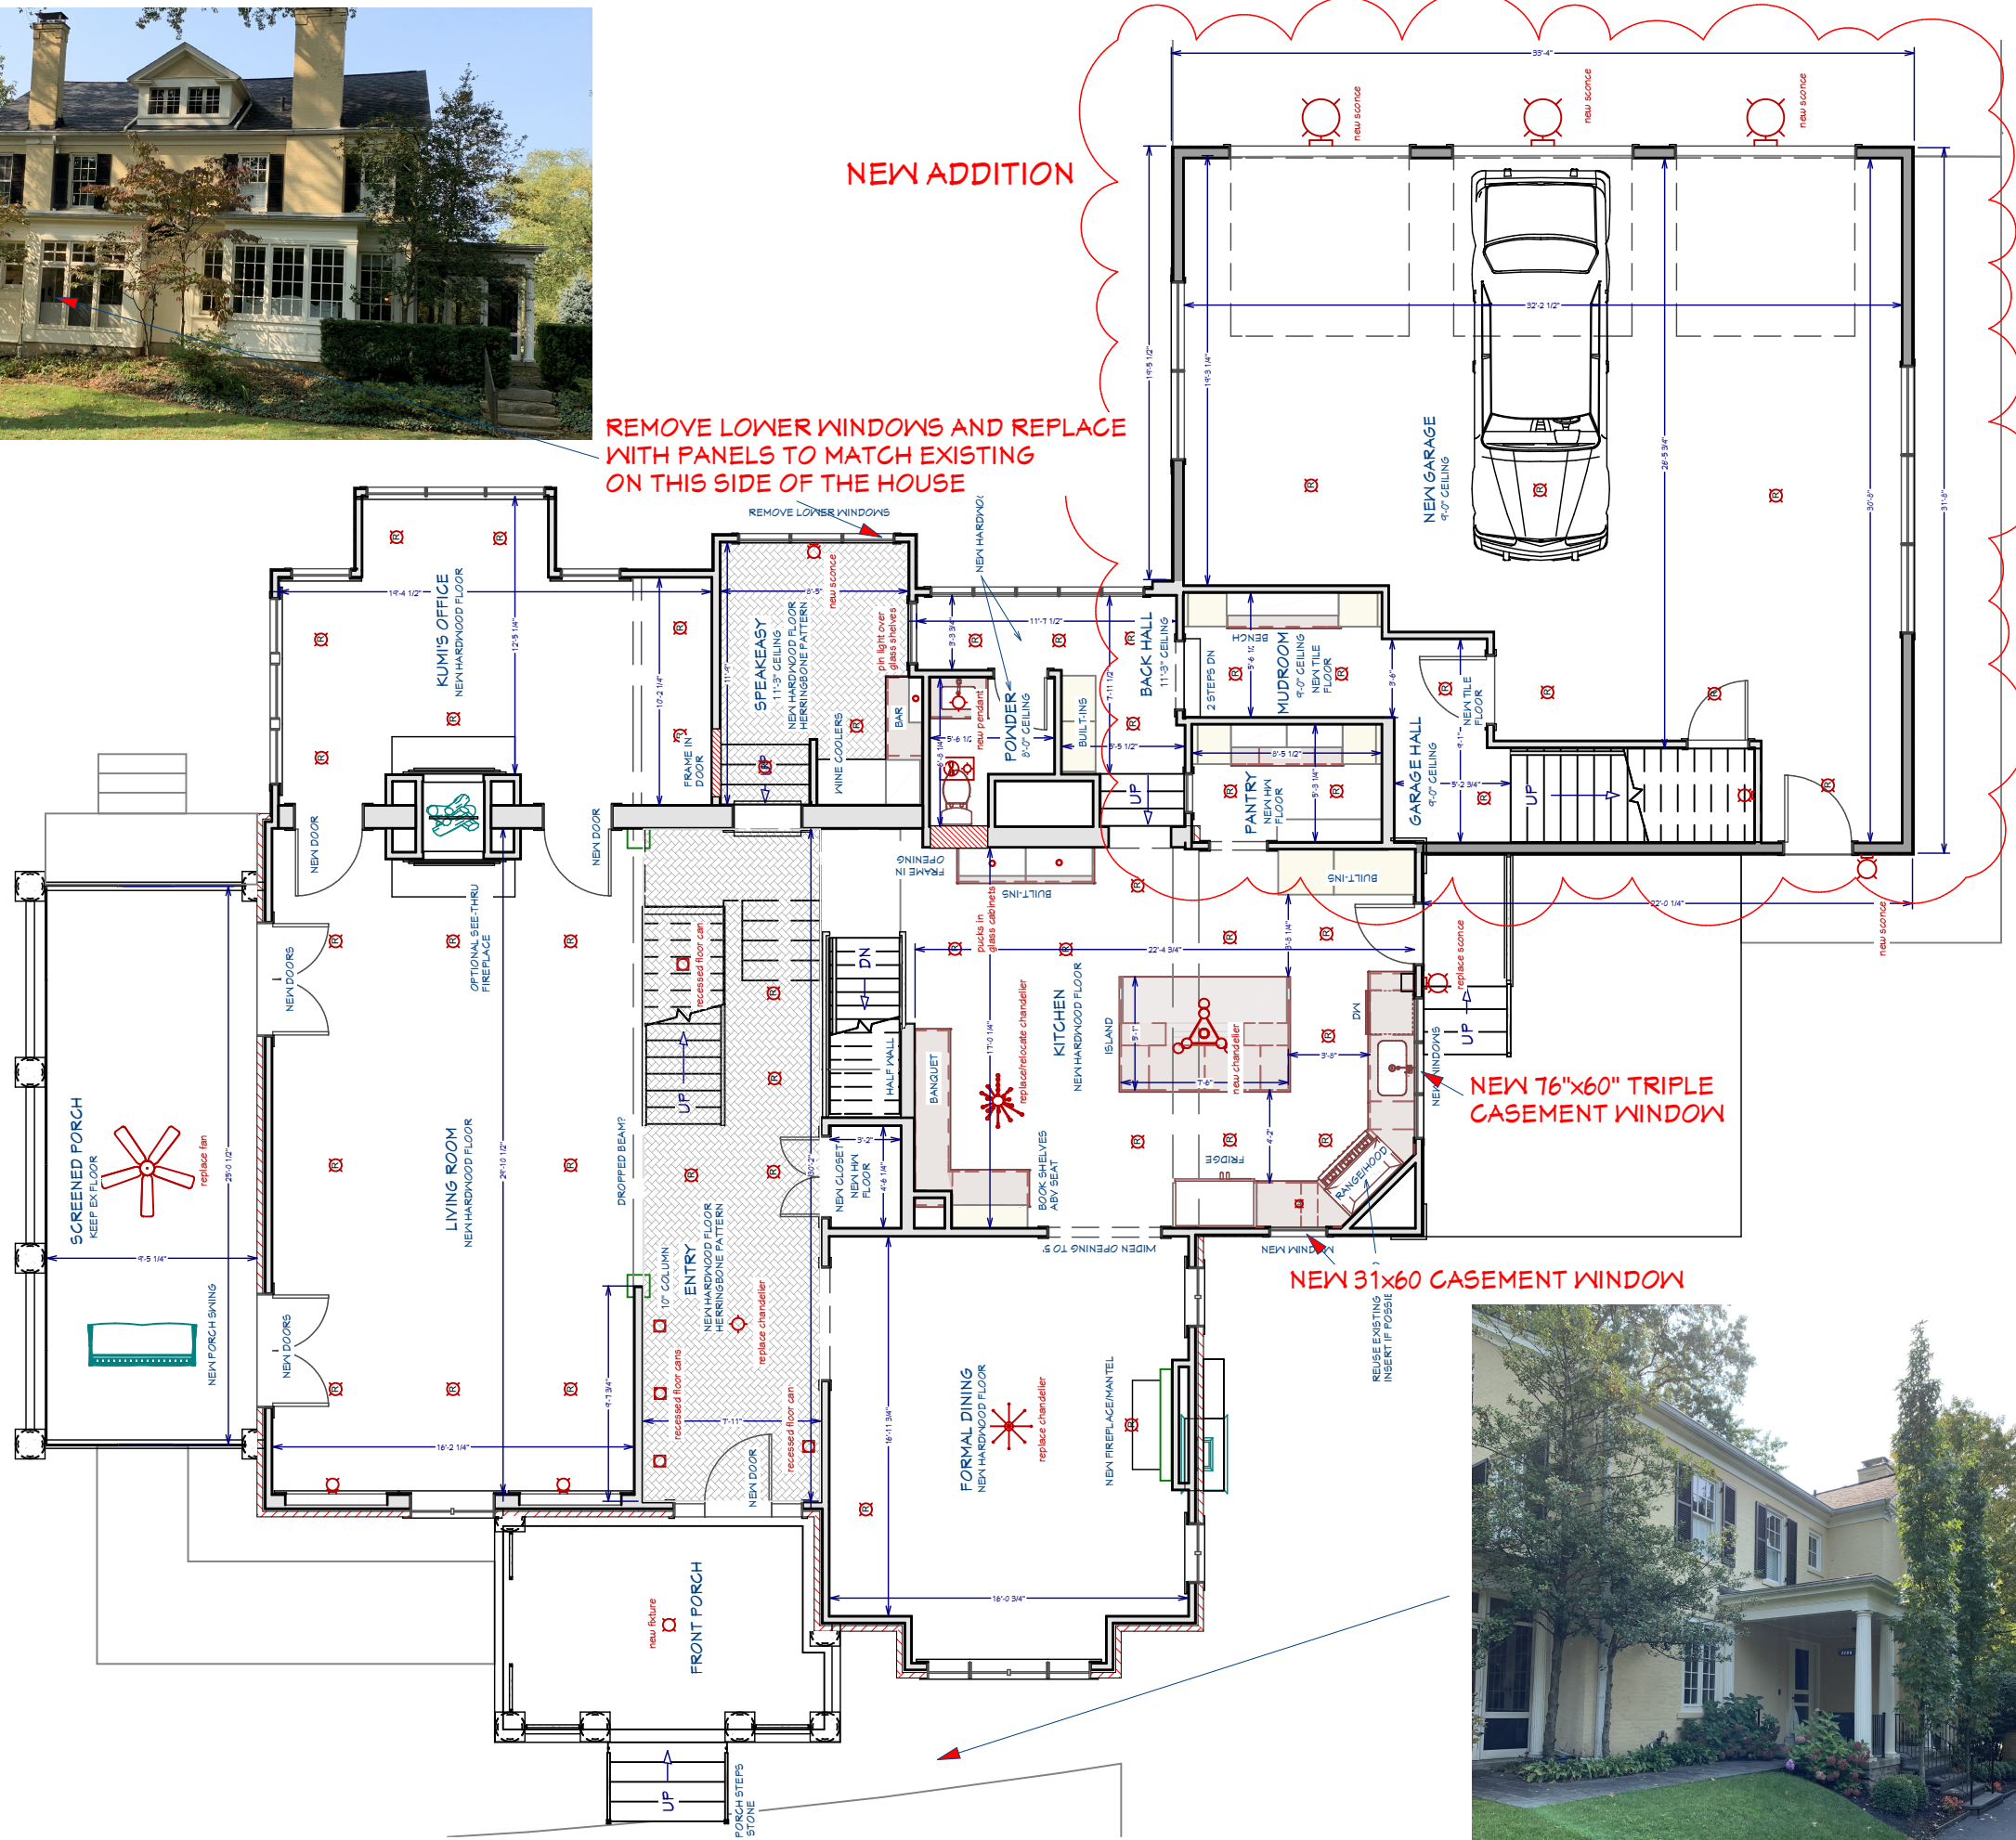

**NEW ADDITION**

**REMOVE LOWER WINDOWS AND REPLACE WITH PANELS TO MATCH EXISTING ON THIS SIDE OF THE HOUSE**

**NEW 76"x60" TRIPLE CASEMENT WINDOW**

**NEW 31"x60" CASEMENT WINDOW**

Copyright © 2021 The Cleary Company. Concepts and drawings contained herein remain the property of The Cleary Company and may not be reproduced or translated without the written permission of a The Cleary Company representative.



DRAWINGS PROVIDED BY:  
 THE CLEARY COMPANY  
 989 Old Henderson Rd  
 COLUMBUS, OH 43220  
 614.459.4000

**WALKER-PEACOCK RESIDENCE**  
 2299 COMMONWEALTH PARK S - BEXLEY, OHIO 43209

**NEW FIRST FLOOR PLAN**

| REVISIONS |      |
|-----------|------|
| NO.       | DATE |
|           |      |
|           |      |
|           |      |
|           |      |

ISSUE DATE:  
2/10/2021

PROJECT #2299-C-20

SCALE:  
1/8"=1'

SHEET NO.  
**4**




DRAWINGS PROVIDED BY:

THE CLEARY COMPANY  
 989 Old Henderson Rd  
 COLUMBUS, OH 43220  
 614.459.4000

**WALKER-PEACOCK RESIDENCE**  
 2299 COMMONWEALTH PARK S - BEXLEY, OHIO 43209

**NEW SECOND FLOOR PLAN**

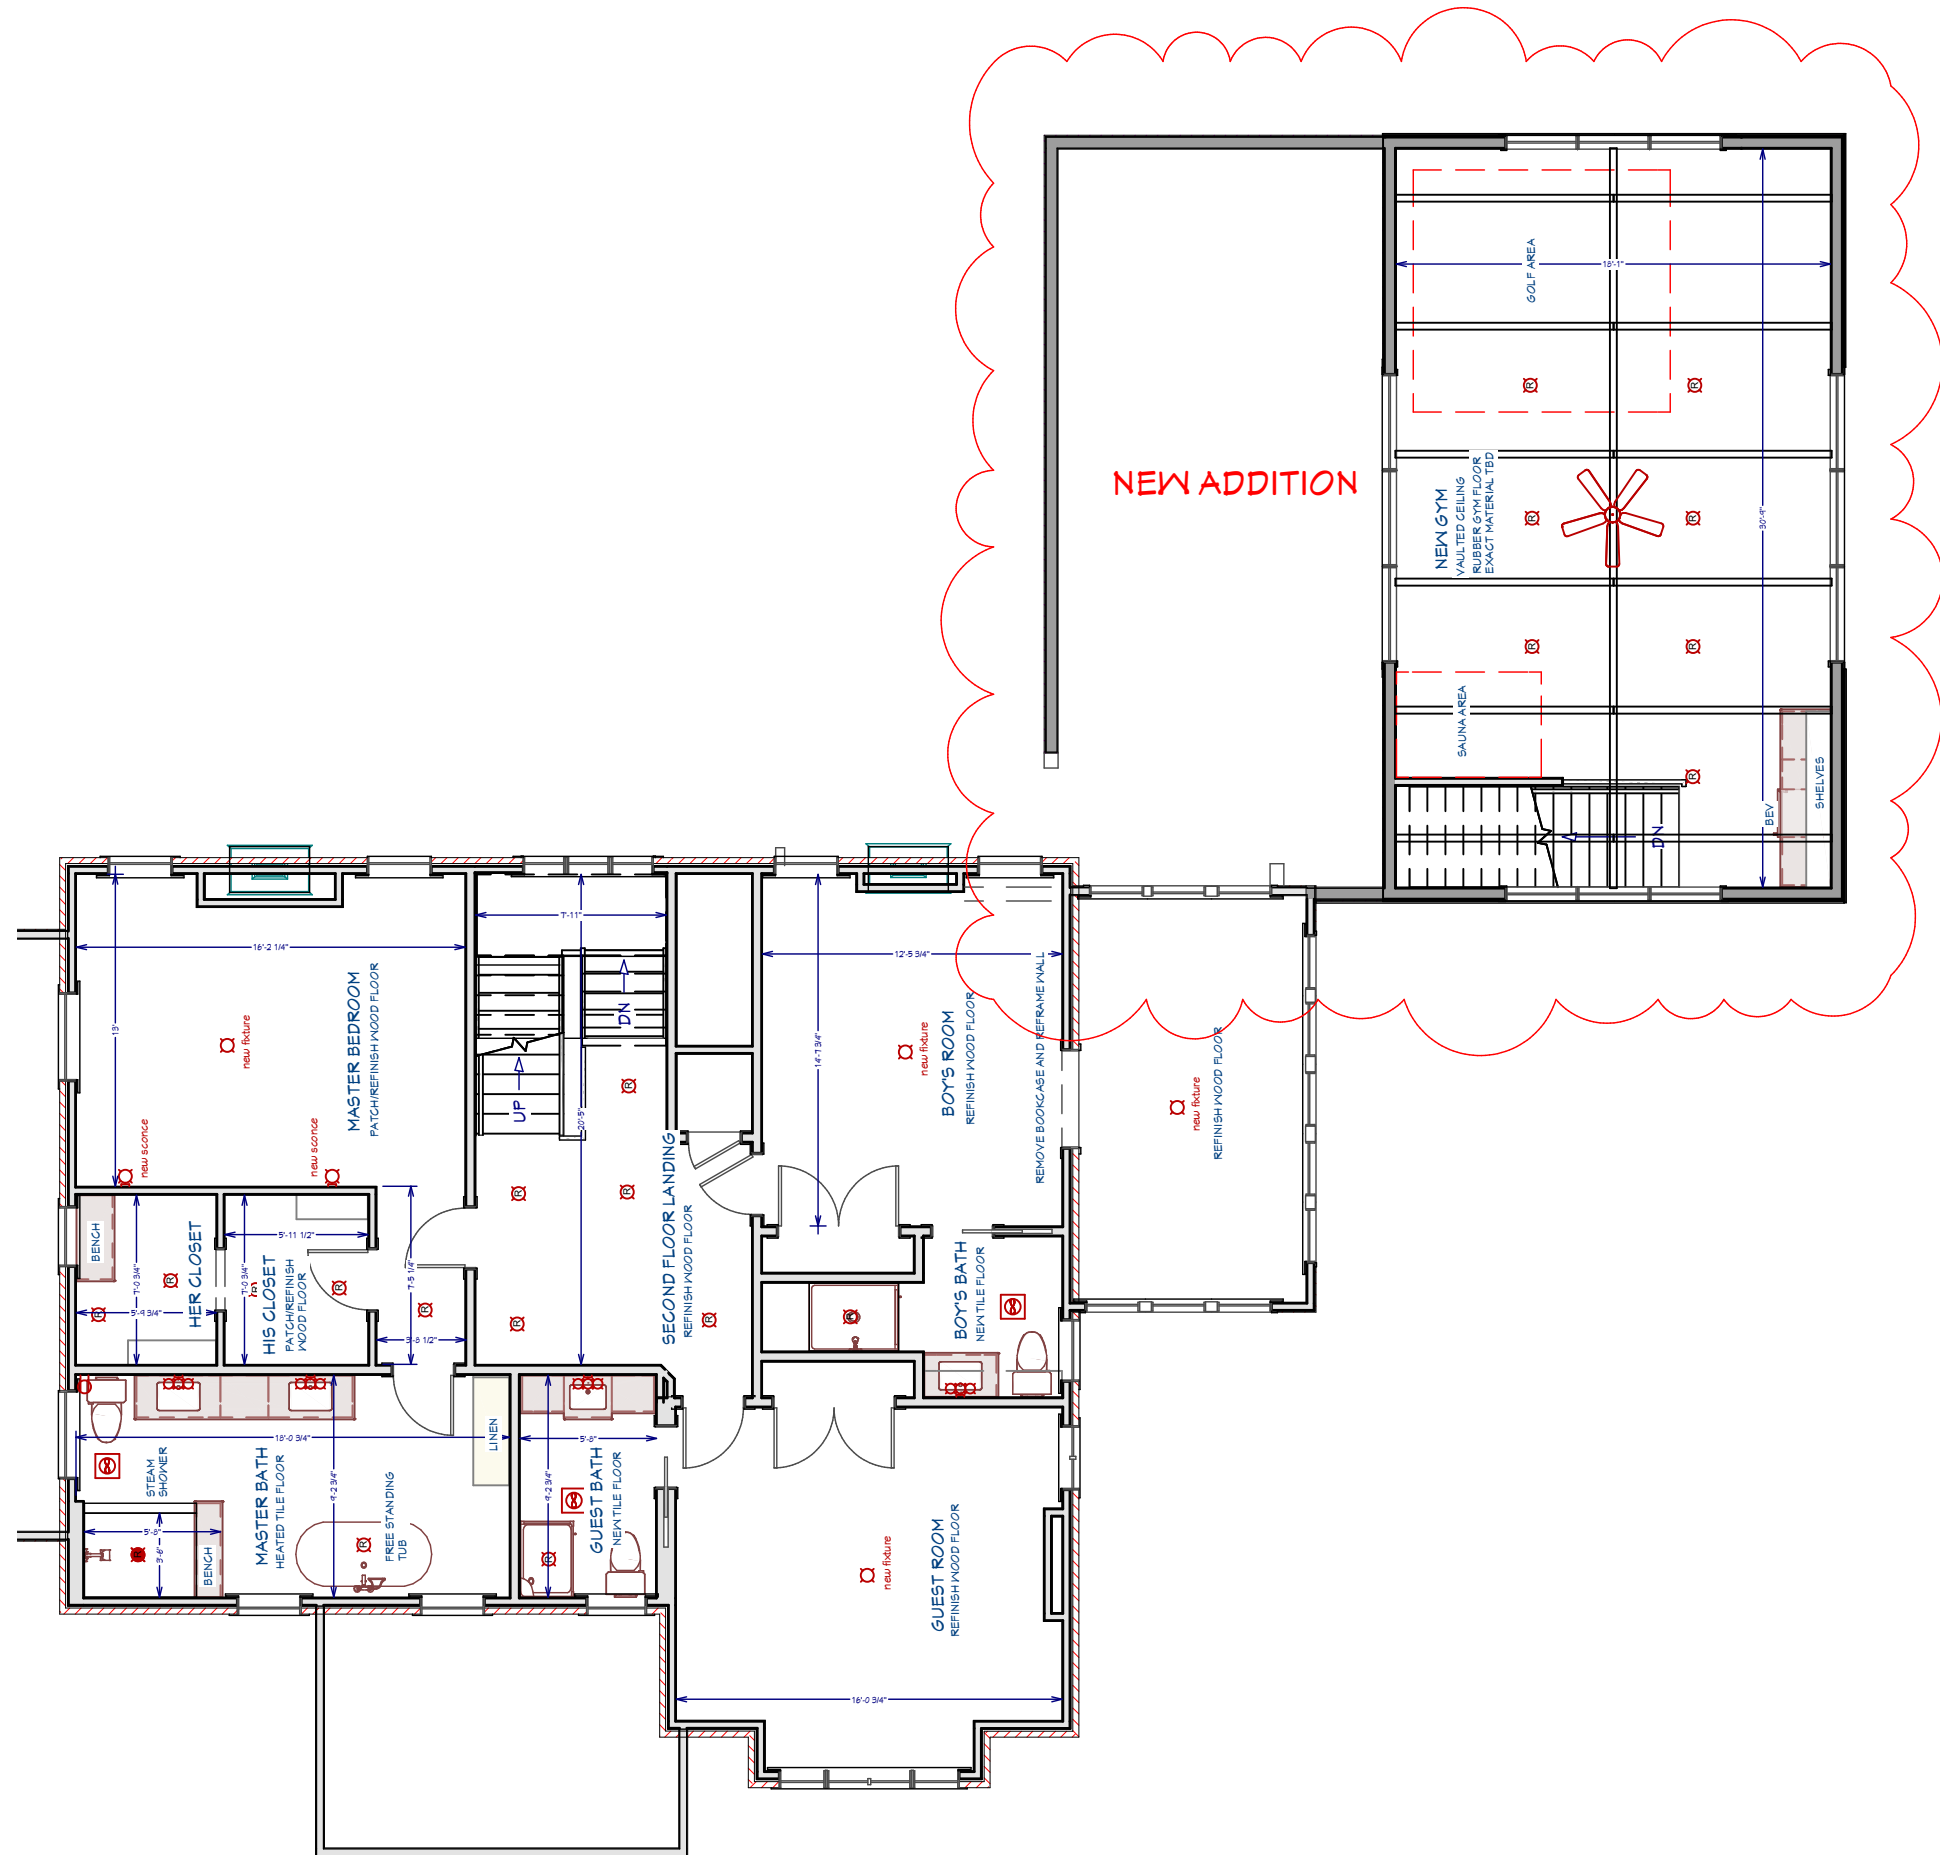

REVISIONS

| NO. | DATE |
|-----|------|
|     |      |
|     |      |
ISSUE DATE:  
2/10/2021

PROJECT #2299-C-20

SCALE:  
1/8"=1'

SHEET NO.

**5**



DRAWINGS PROVIDED BY:

THE CLEARY COMPANY  
 989 Old Henderson Rd  
 COLUMBUS, OH 43220  
 614.459.4000

**WALKER-PEACOCK RESIDENCE**  
 2299 COMMONWEALTH PARK S - BEXLEY, OHIO 43209

**EXTERIOR ELEVATIONS**

| REVISIONS |      |
|-----------|------|
| NO.       | DATE |
|           |      |
|           |      |
ISSUE DATE:  
2/10/2021

PROJECT #2299-C-20


SCALE:  
1/8"=1'

SHEET NO.  
**6**



EXISTING HOME WEST ELEVATION

NEW ADDITION WEST ELEVATION

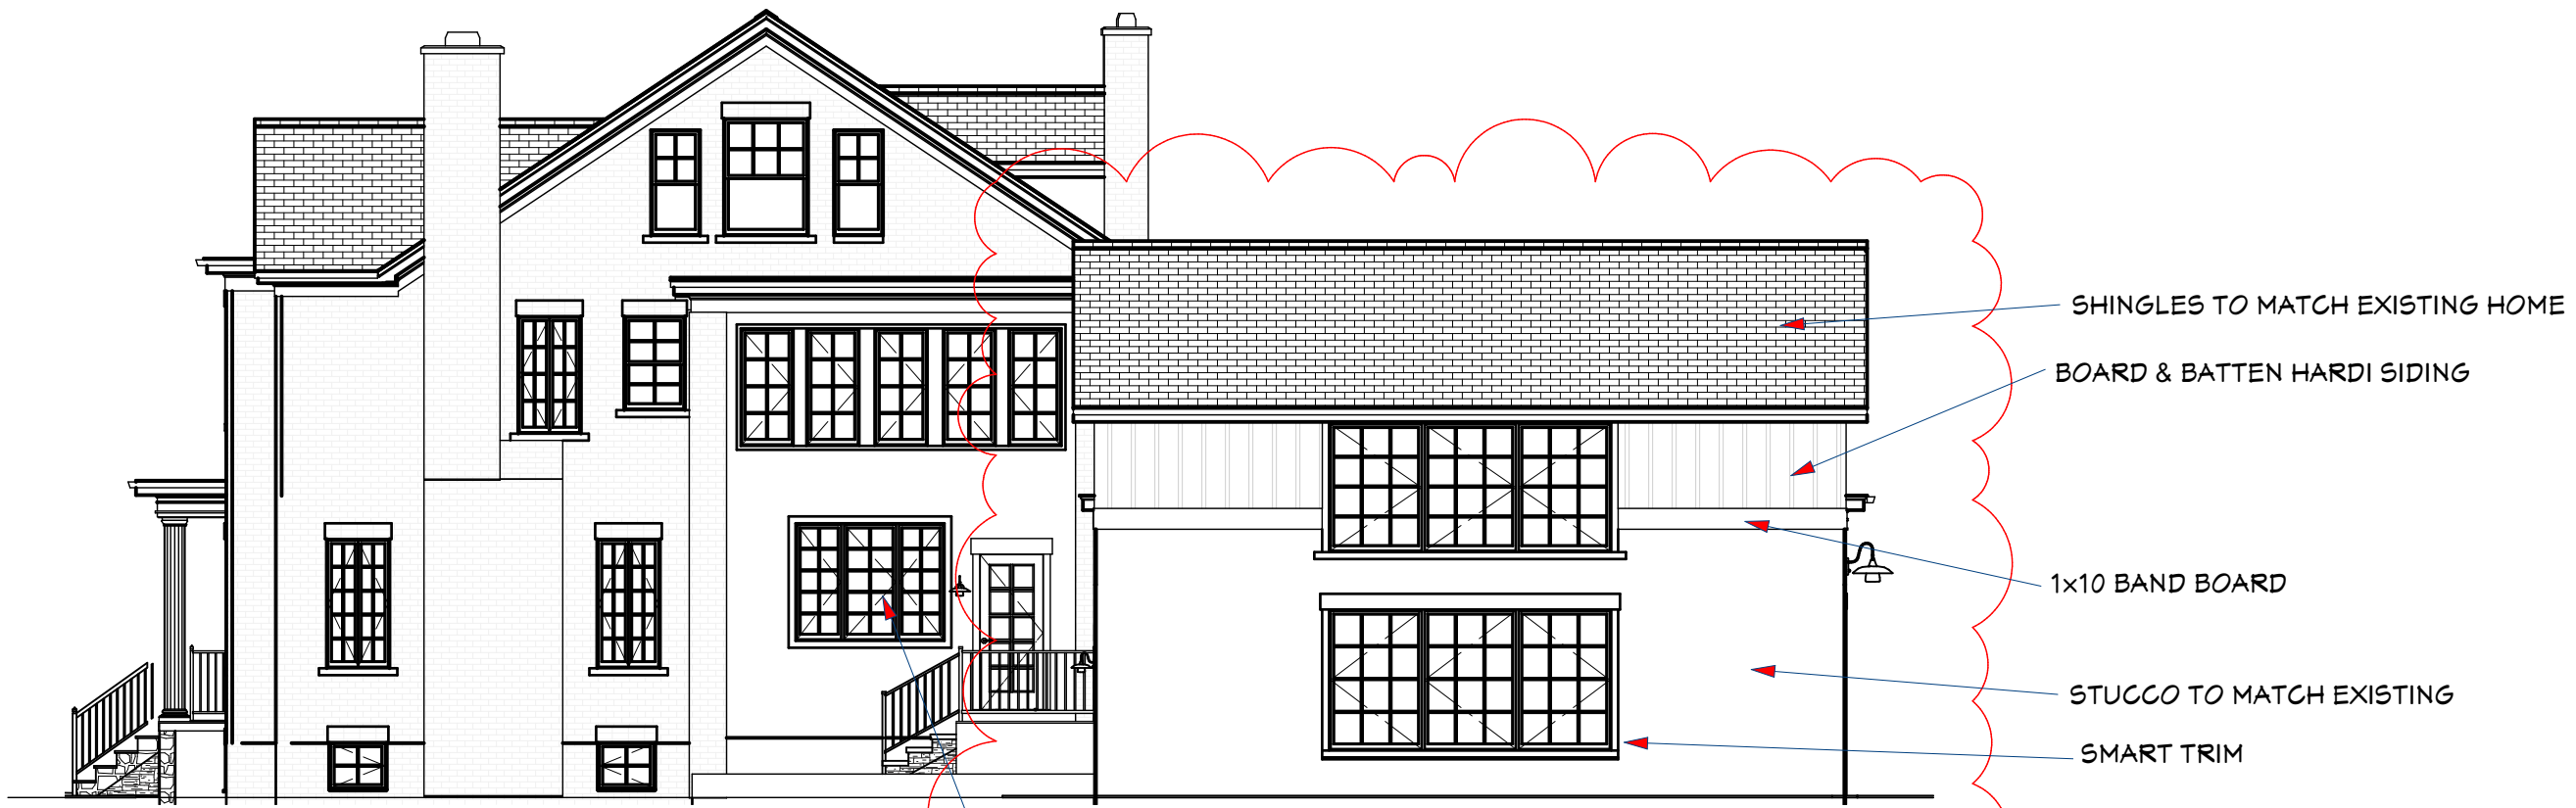

EXISTING HOME SOUTH ELEVATION

NEW ADDITION SOUTH ELEVATION

Copyright © 2021 The Cleary Company. Concepts and drawings contained herein remain the property of The Cleary Company and may not be reproduced or translated without the written permission of a The Cleary Company representative.



DRAWINGS PROVIDED BY:  
 THE CLEARY COMPANY  
 989 Old Henderson Rd  
 COLUMBUS, OH 43220  
 614.459.4000

**WALKER-PEACOCK RESIDENCE**  
 2299 COMMONWEALTH PARK S - BEXLEY, OHIO 43209

**EXTERIOR RENDERINGS**

REVISIONS

| NO. | DATE |
|-----|------|
|     |      |
|     |      |


ISSUE DATE:  
2/10/2021

PROJECT #2299-C-20

SCALE:  
1/8"=1'

SHEET NO.

**7**

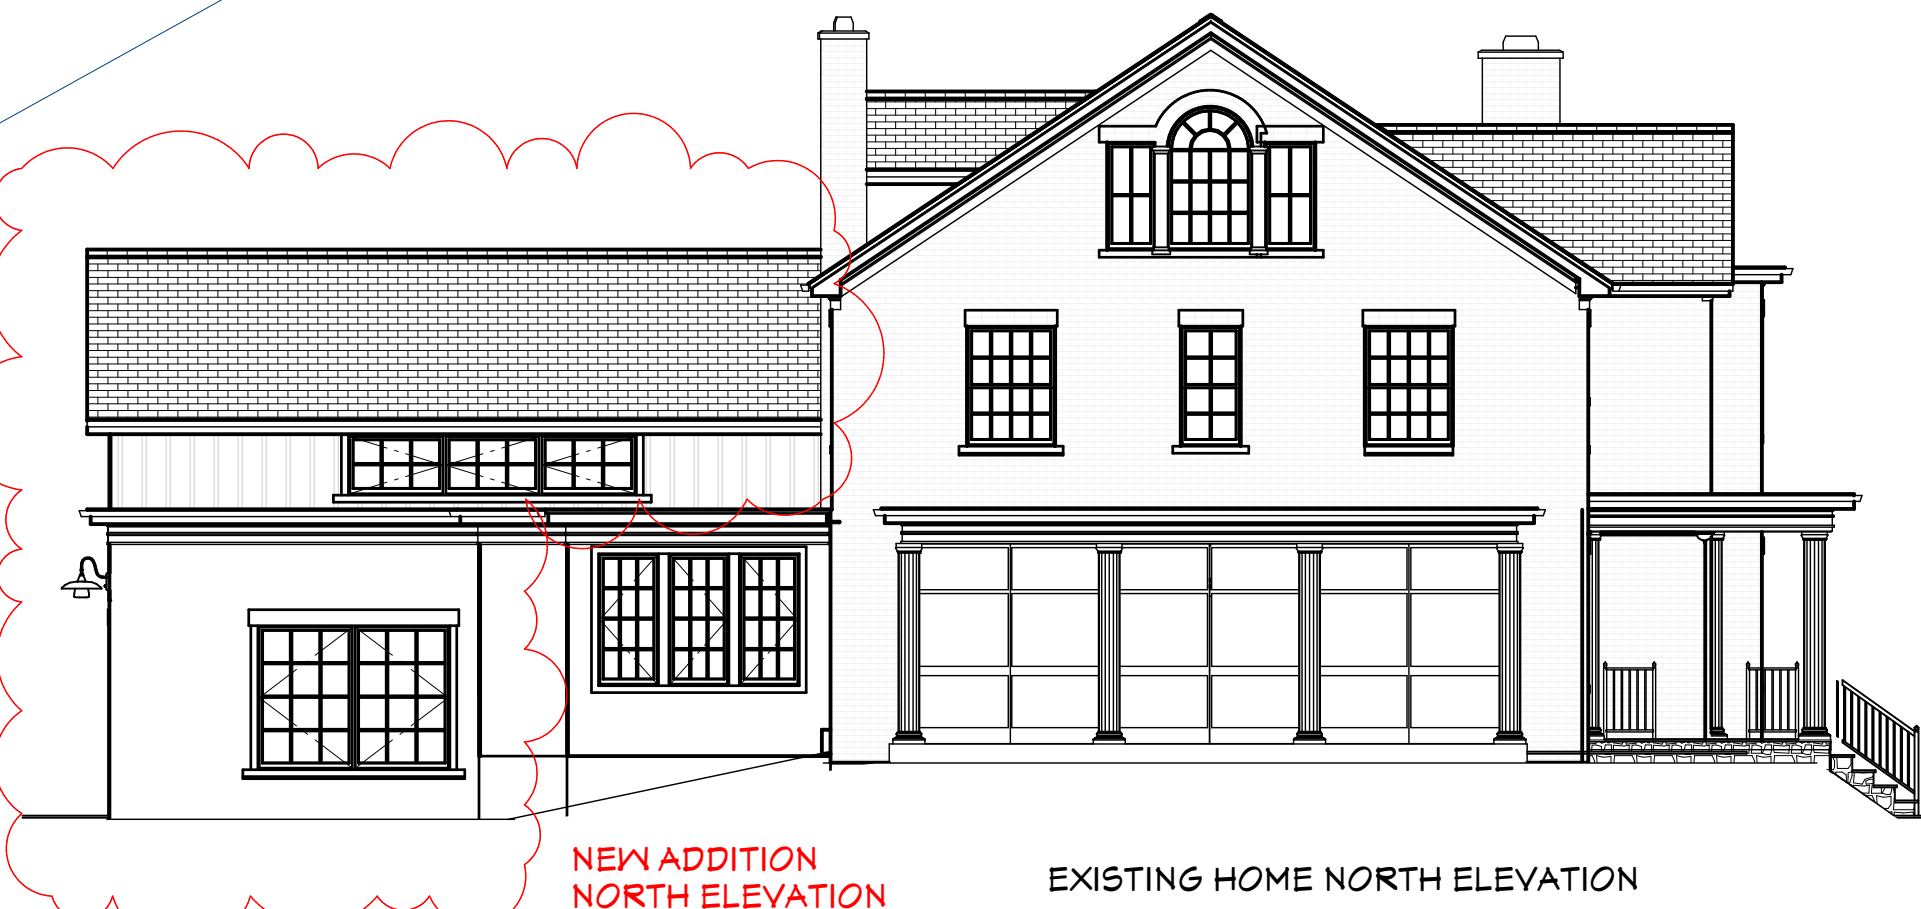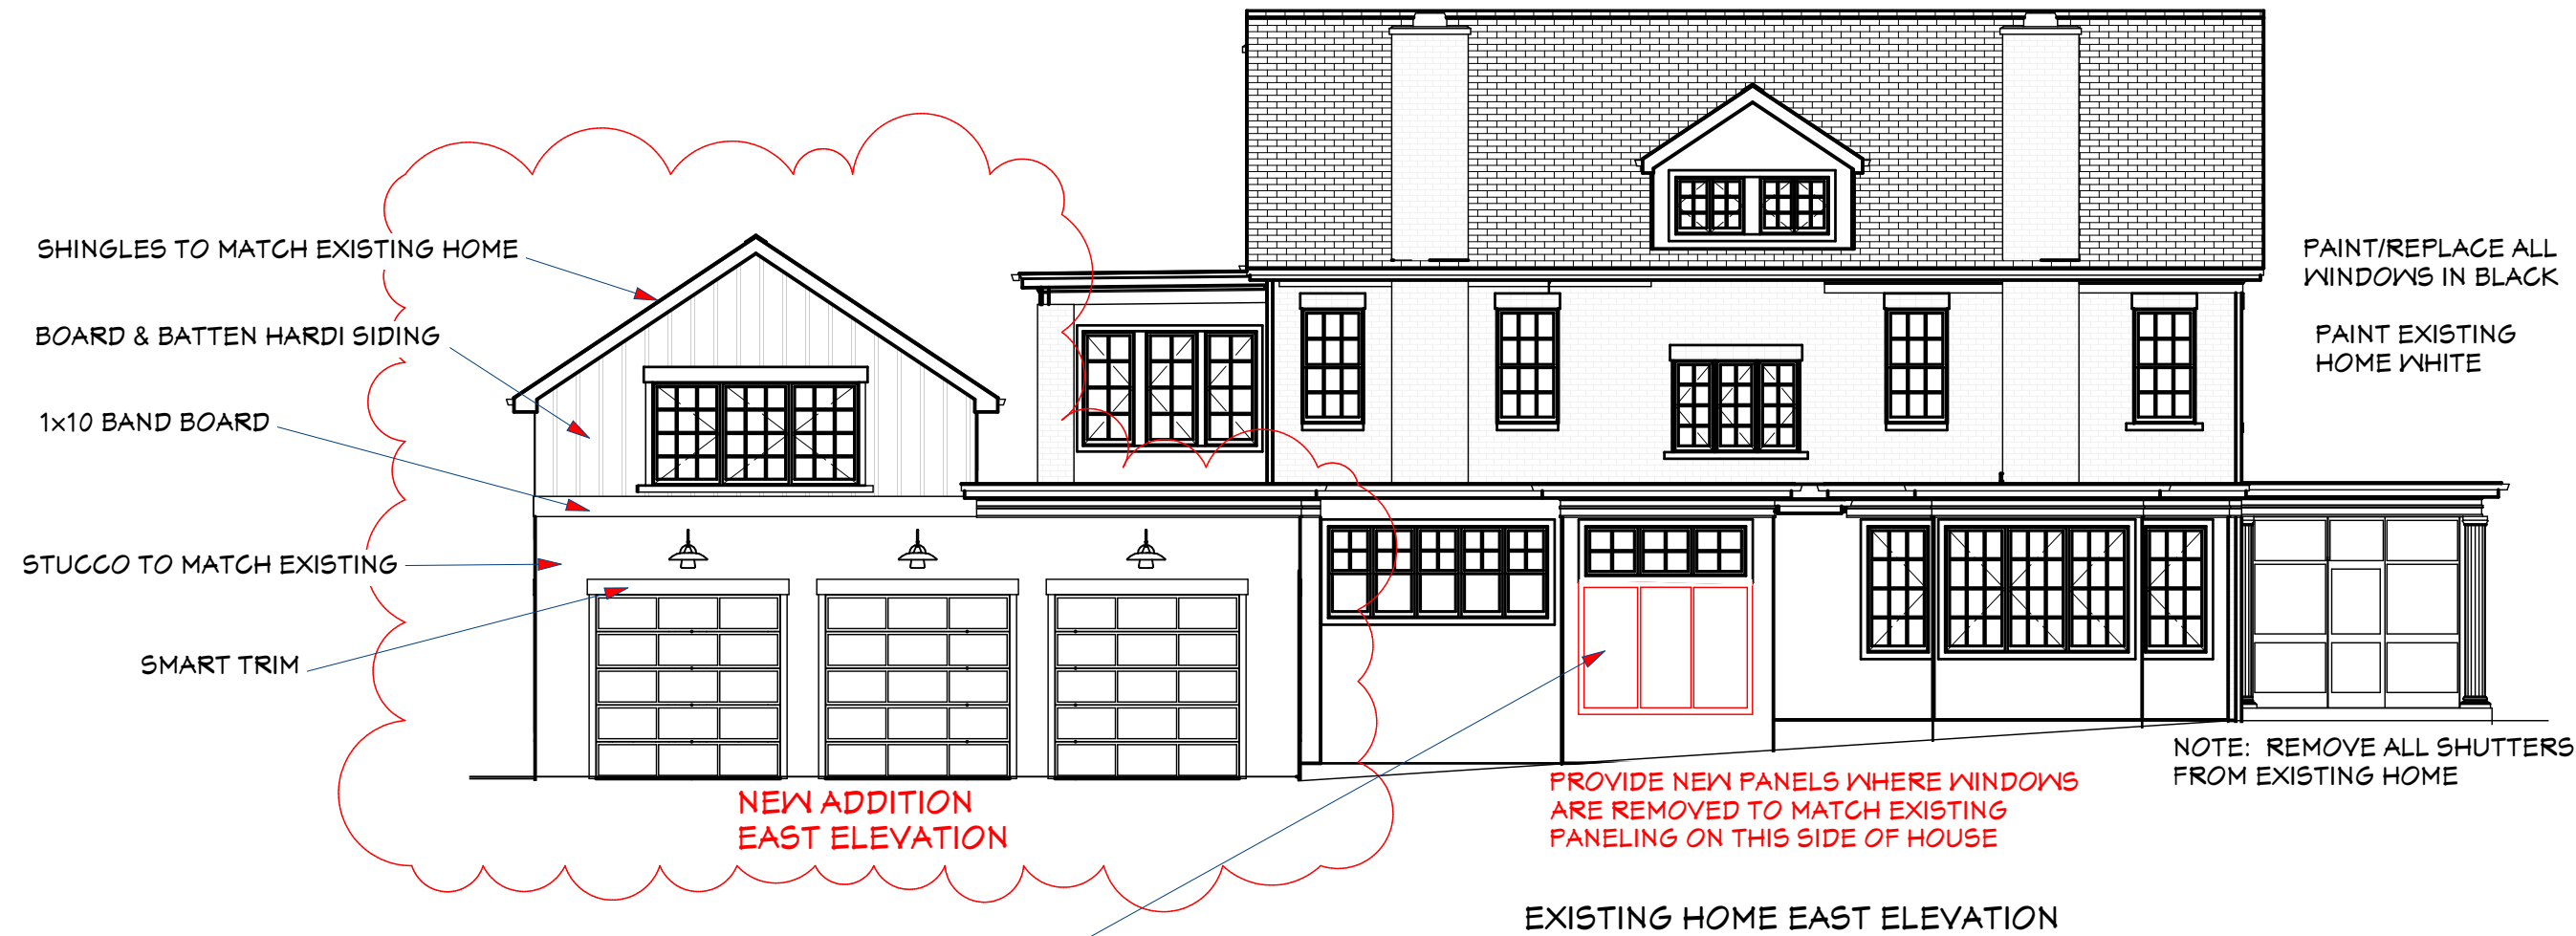





NEW ADDITION



DRAWINGS PROVIDED BY:

THE CLEARY COMPANY  
989 Old Henderson Rd  
COLUMBUS, OH 43220  
614.459.4000

**WALKER-PEACOCK RESIDENCE**  
2299 COMMONWEALTH PARK S - BEXLEY, OHIO 43209

**EXTERIOR RENDERINGS**

REVISIONS

| NO. | DATE |
|-----|------|
|     |      |
|     |      |
|     |      |
|     |      |

ISSUE DATE:  
2/10/2021

PROJECT #2299-C-20

SCALE:  
NA

SHEET NO.

8