


first floor

1/8" = 1'-0"

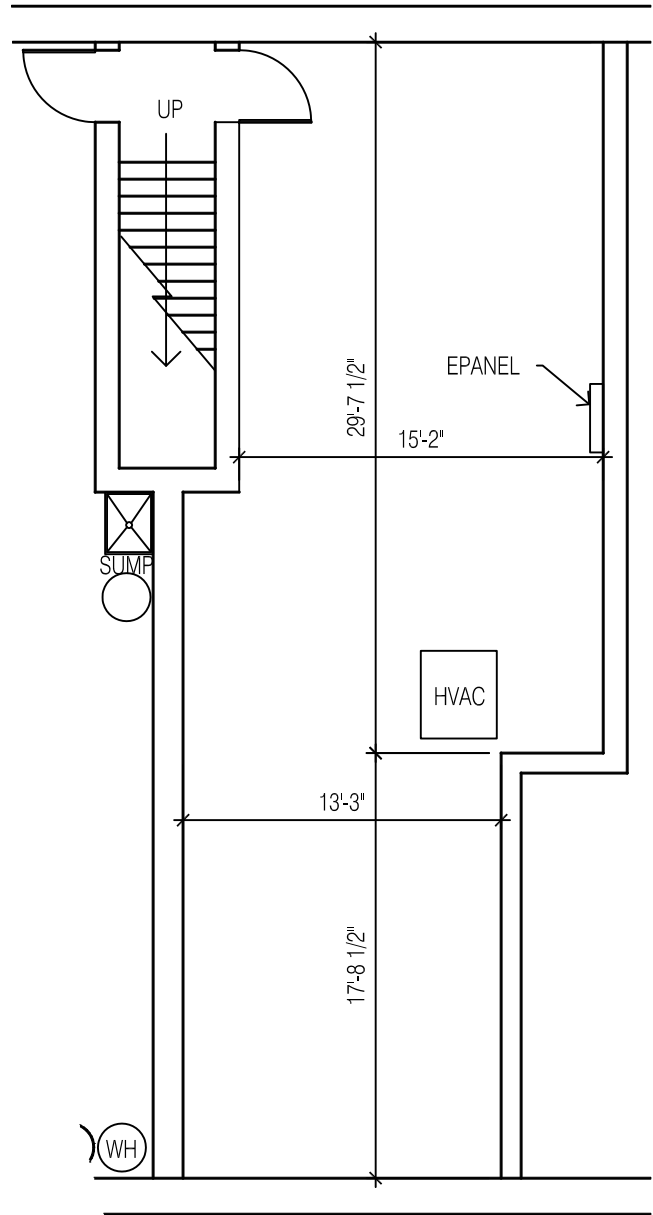

lower level

1/8" = 1'-0"



CARNEY • RANKER
ARCHITECTS LTD
 5925 Wilcox Place, Suite E Dublin, OH 43016
 Ph. 614-792-1000 Fax 614-792-1001
 mail@carneyranker.com

As Built For:
Cherbourg Bakery

543 South Drexel

06-13-16

AB-1

16116.270