



AS-BUILT NORTH ELEVATION
SCALE: 1/8" = 1'-0"




AS-BUILT WEST ELEVATION
SCALE: 1/8" = 1'-0"

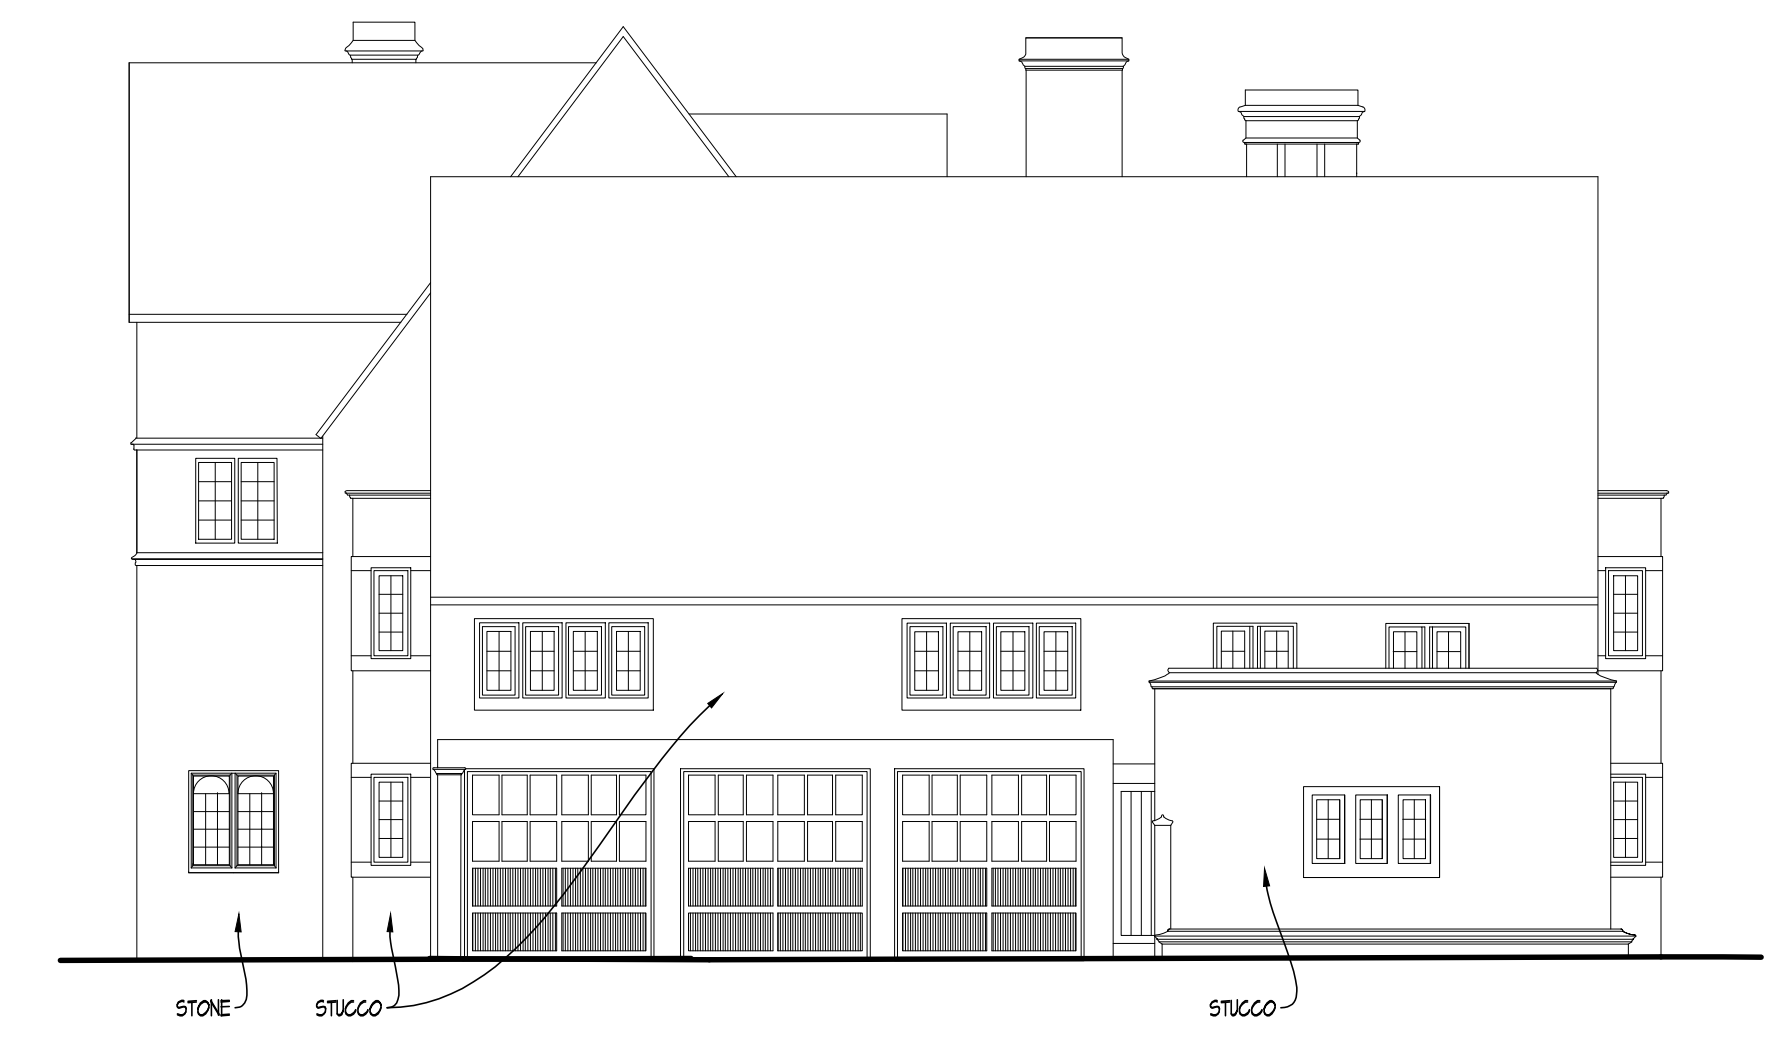

AS-BUILT SOUTH ELEVATION
SCALE: 1/8" = 1'-0"

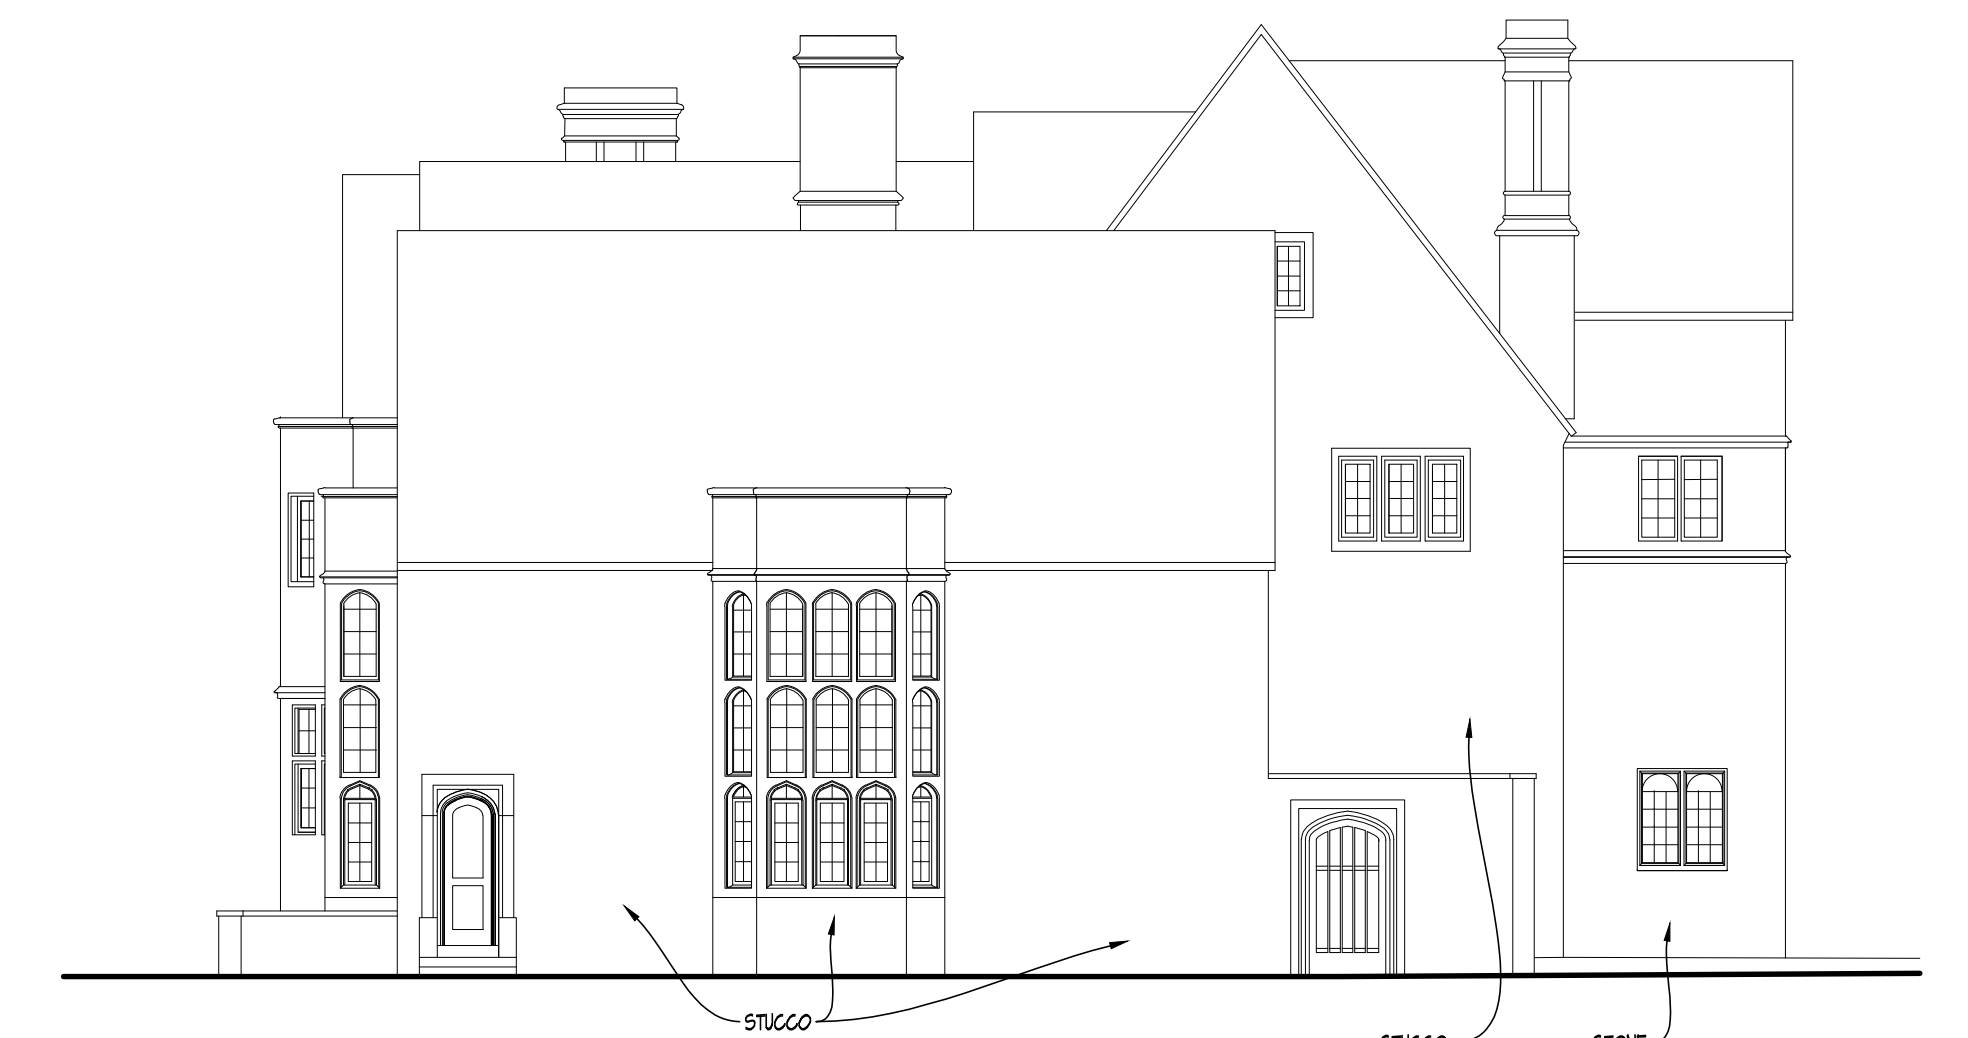


AS-BUILT EAST ELEVATION
SCALE: 1/8" = 1'-0"

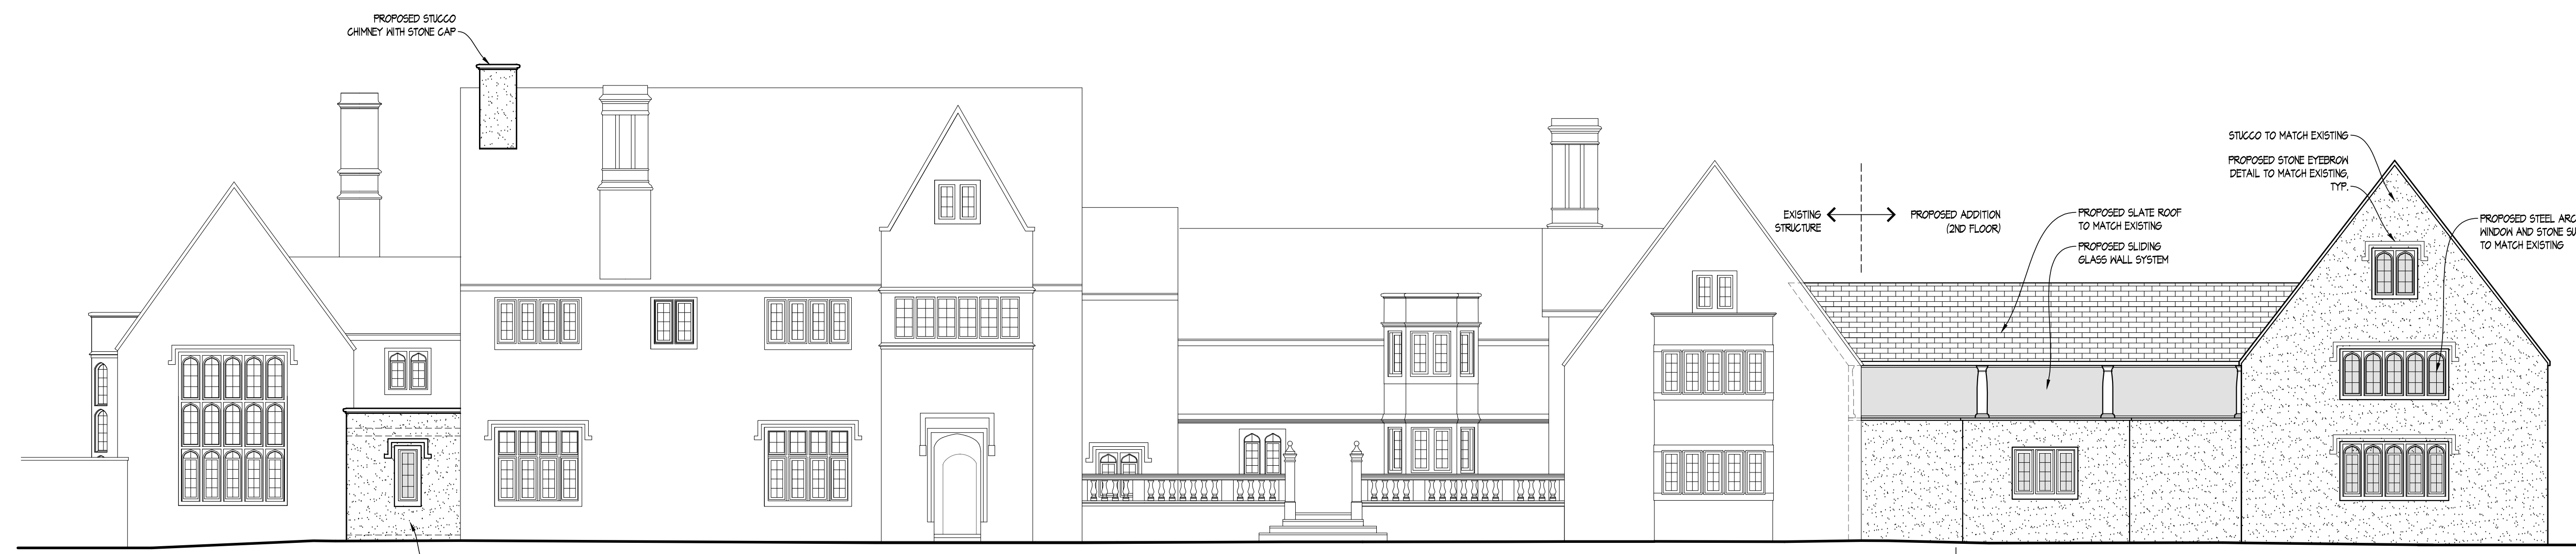

PROPOSED NORTH ELEVATION
 SCALE: 1/8" = 1'-0"




PROPOSED WEST ELEVATION
 SCALE: 1/8" = 1'-0" FROM DRIVEWAY

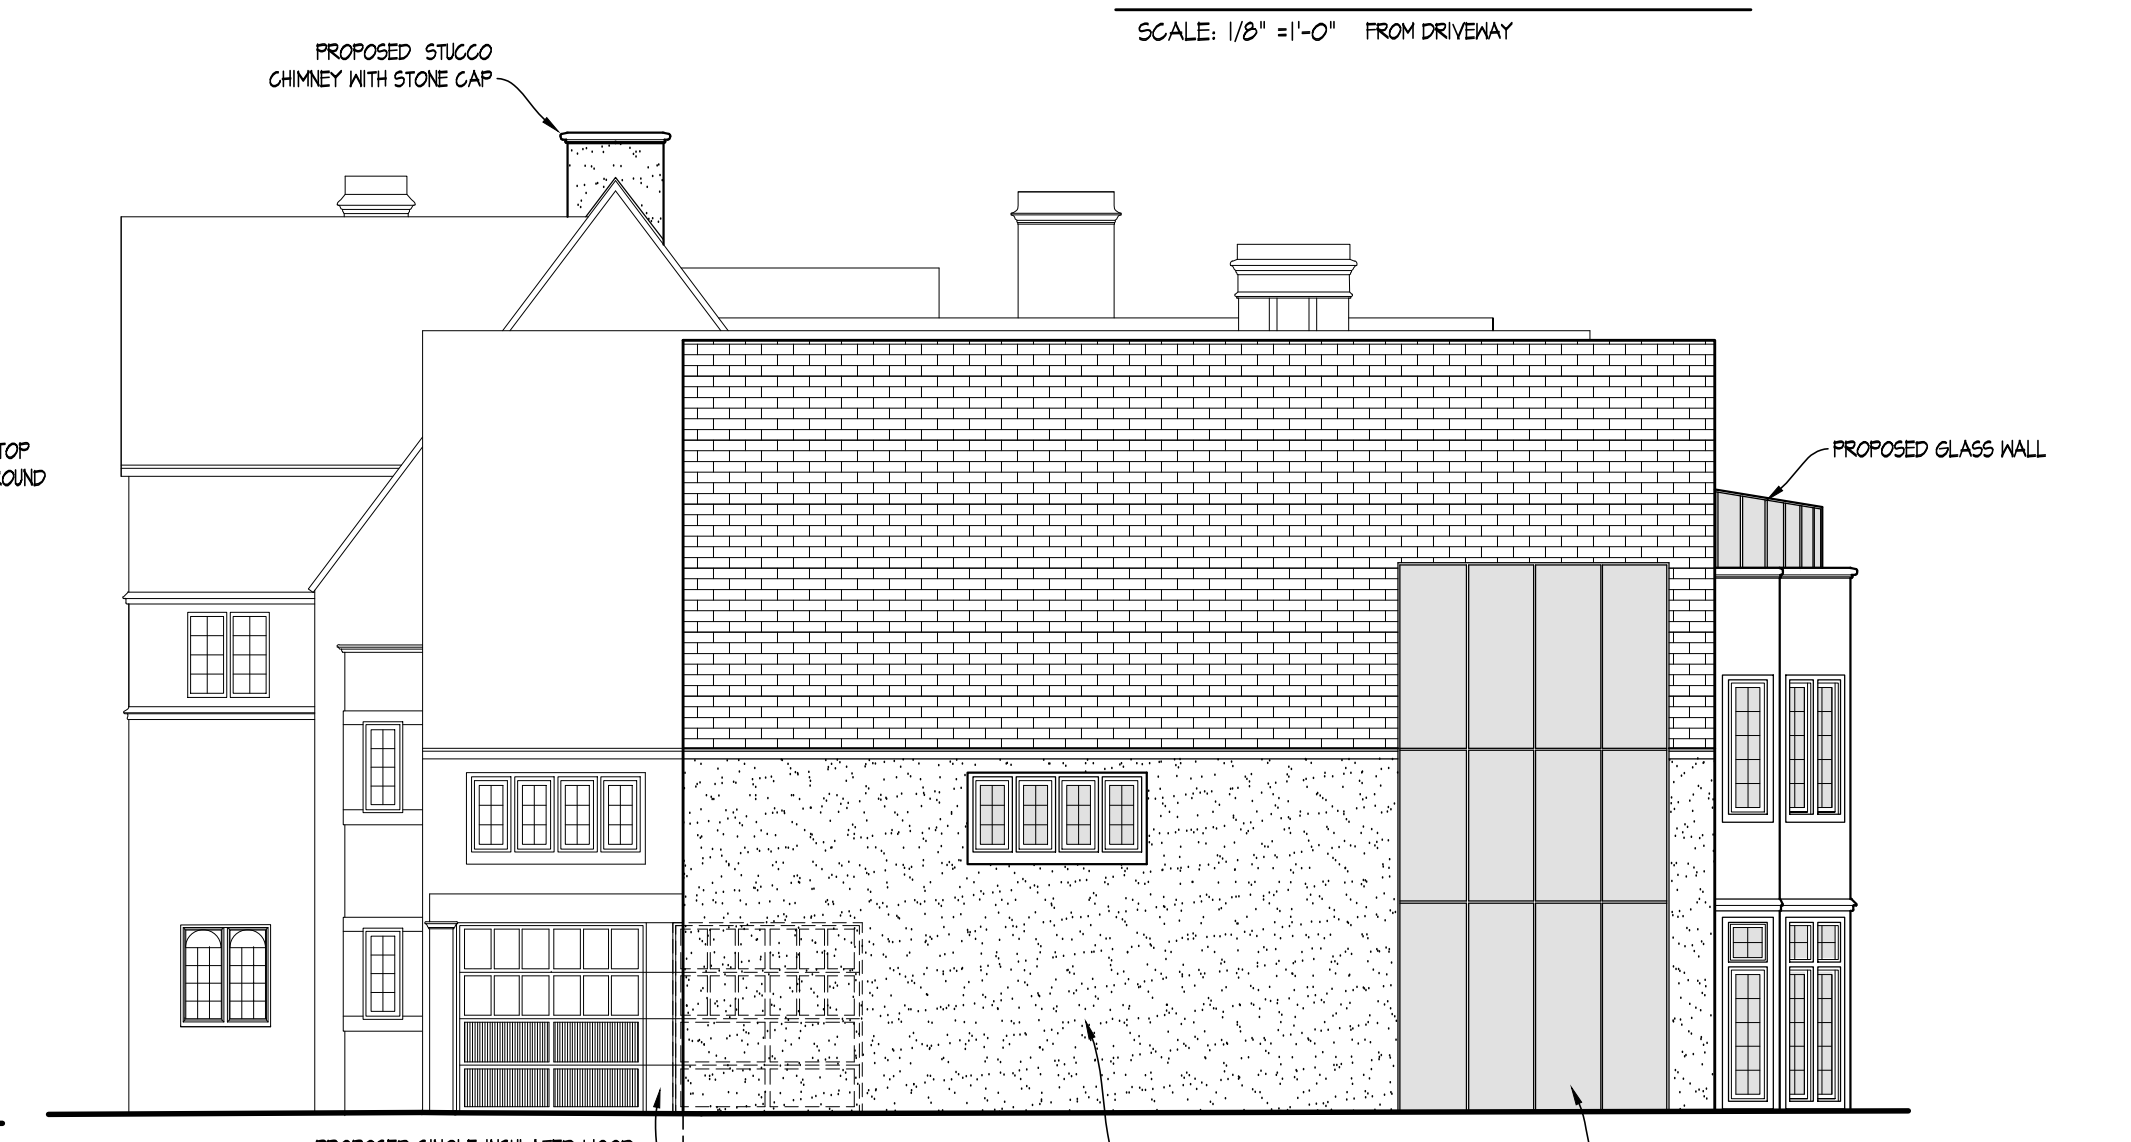

PROPOSED WEST ELEVATION
 SCALE: 1/8" = 1'-0"



PROPOSED SOUTH ELEVATION
 SCALE: 1/8" = 1'-0"

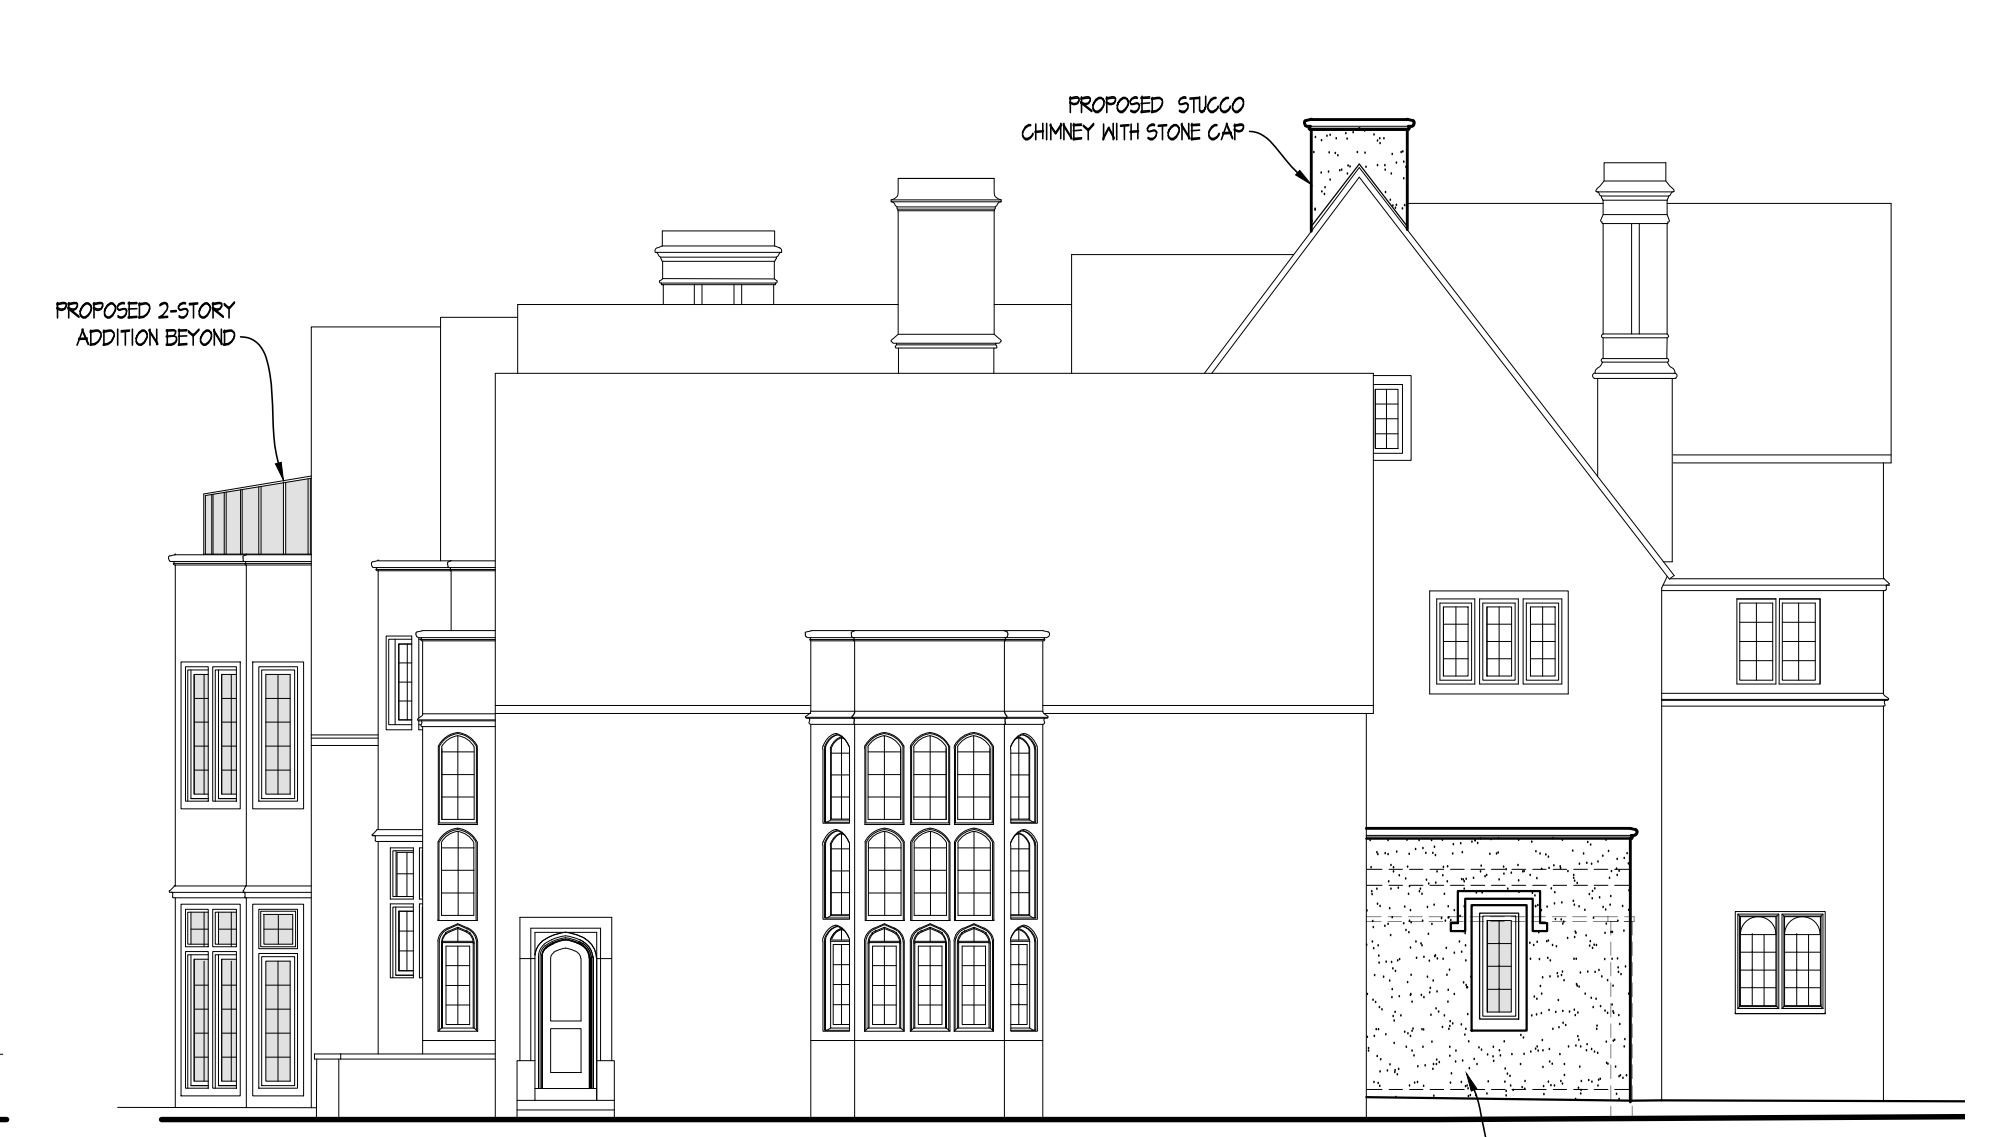

PROPOSED EAST ELEVATION
 SCALE: 1/8" = 1'-0"