



AS-BUILT GROUND FLOOR PLAN
SCALE: 1/8" = 1'-0"

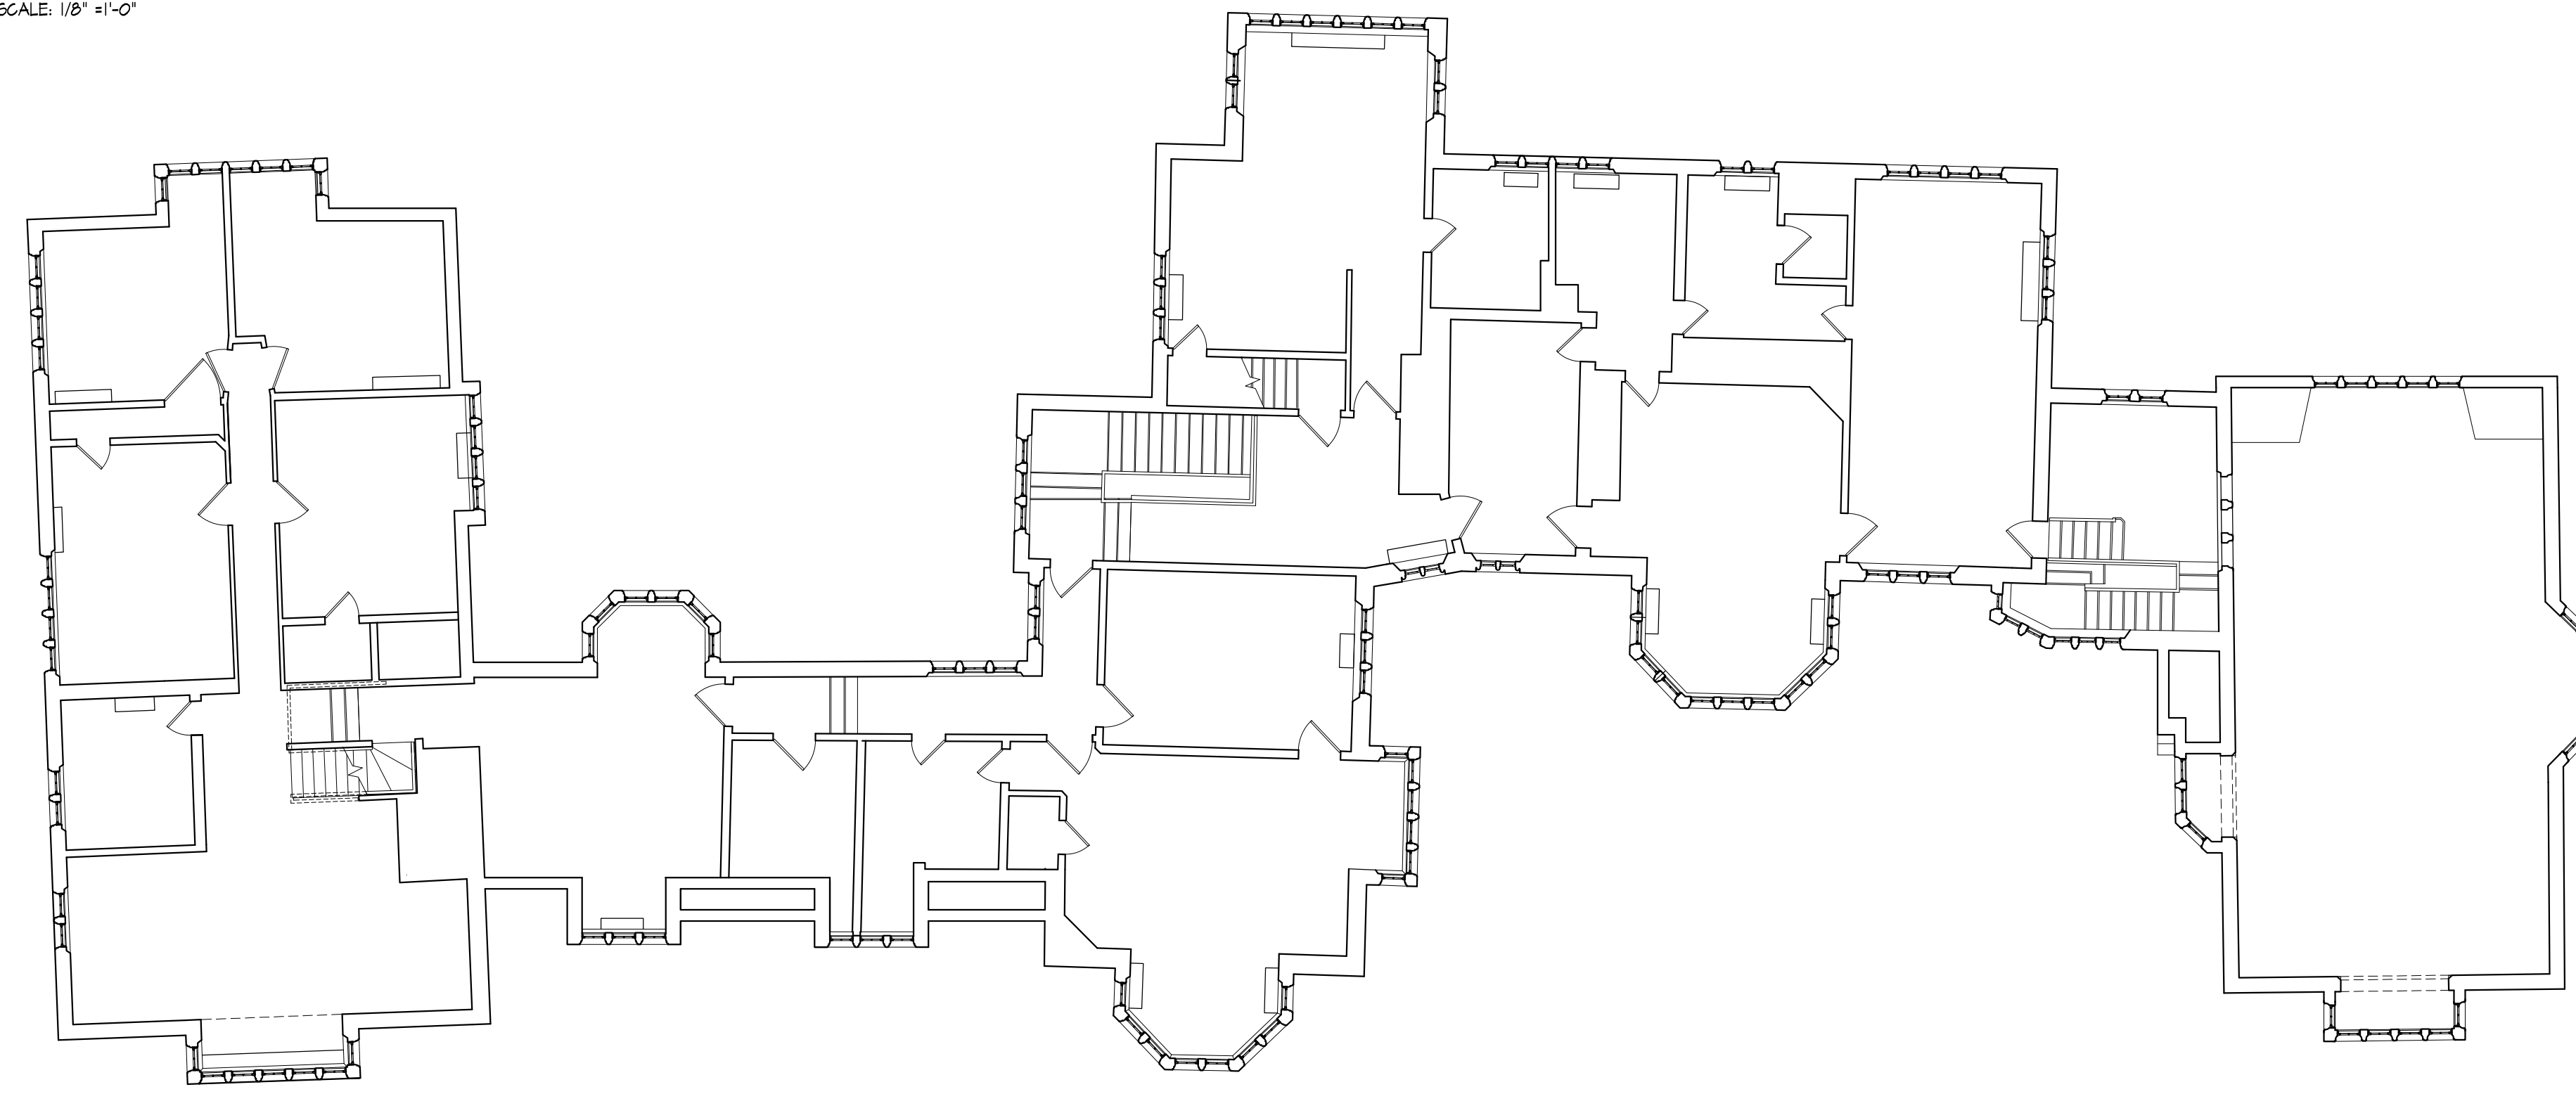

AS-BUILT SECOND FLOOR PLAN
SCALE: 1/8" = 1'-0"

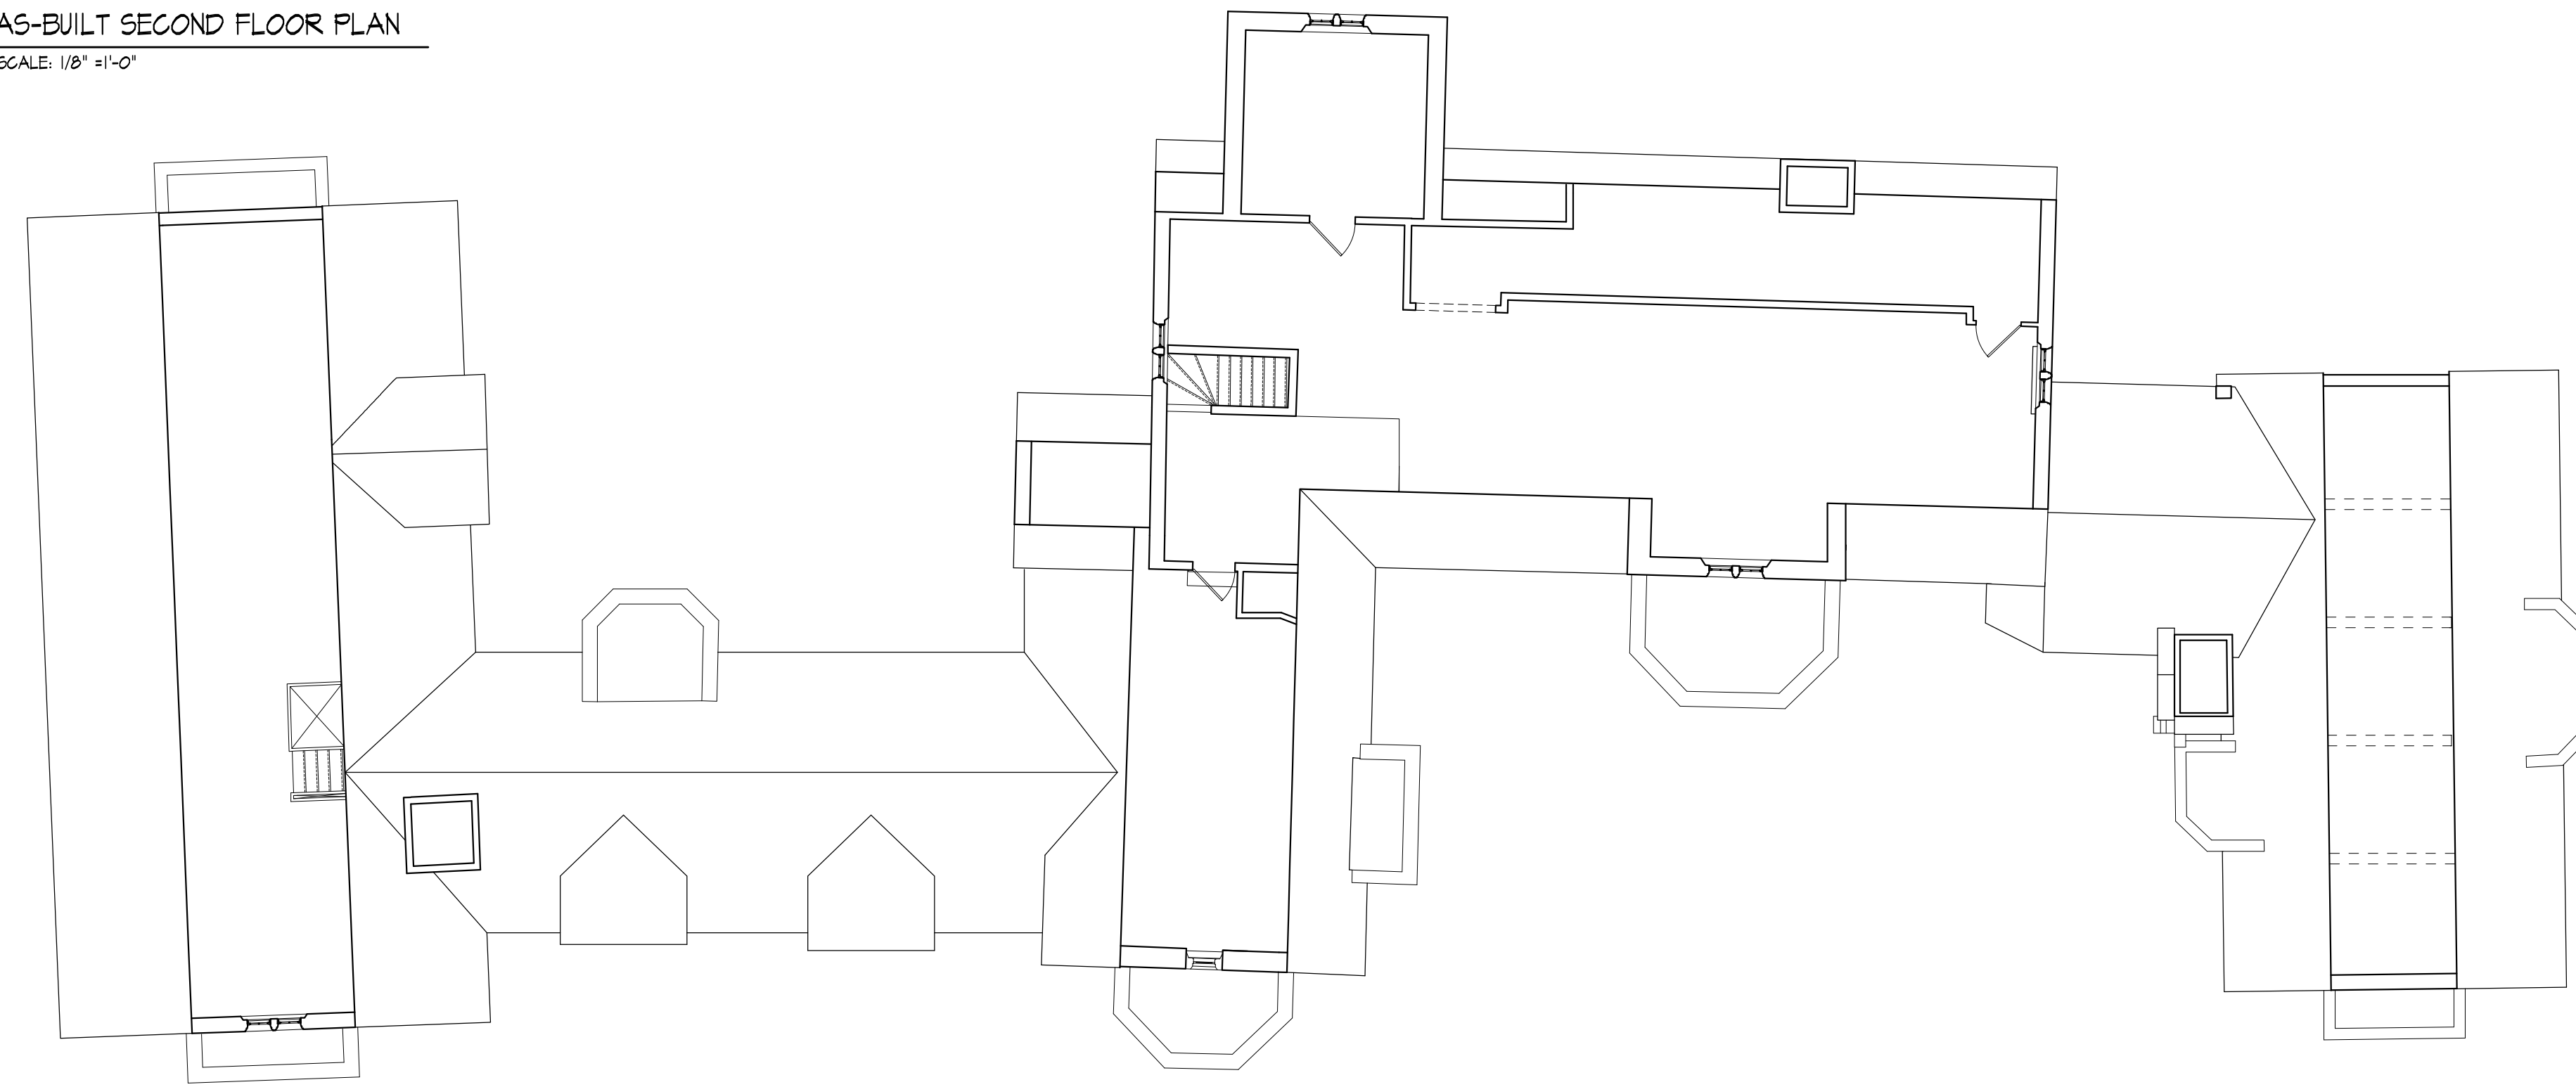

AS-BUILT ATTIC FLOOR PLAN
SCALE: 1/8" = 1'-0"

