




AS-BUILT NORTH ELEVATION  
SCALE: 1/8" = 1'-0"

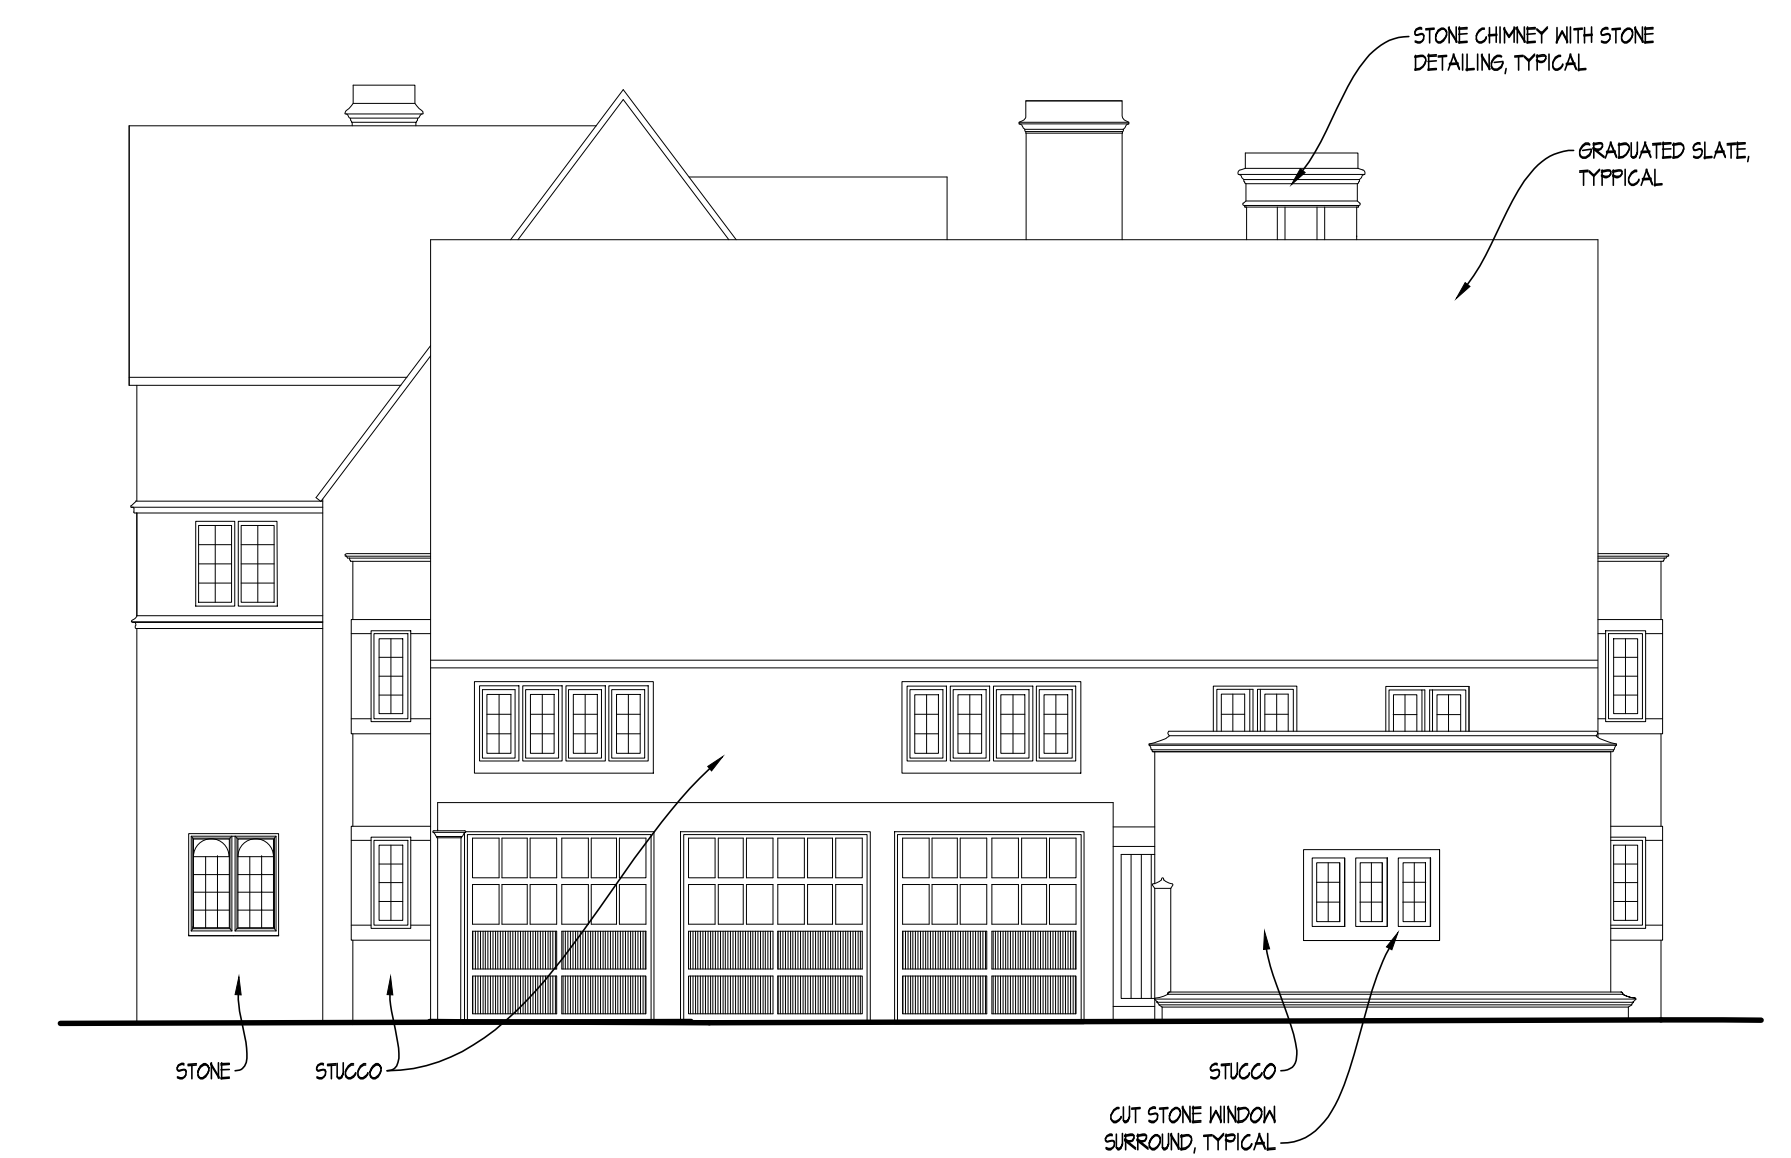

AS-BUILT WEST ELEVATION  
SCALE: 1/8" = 1'-0"

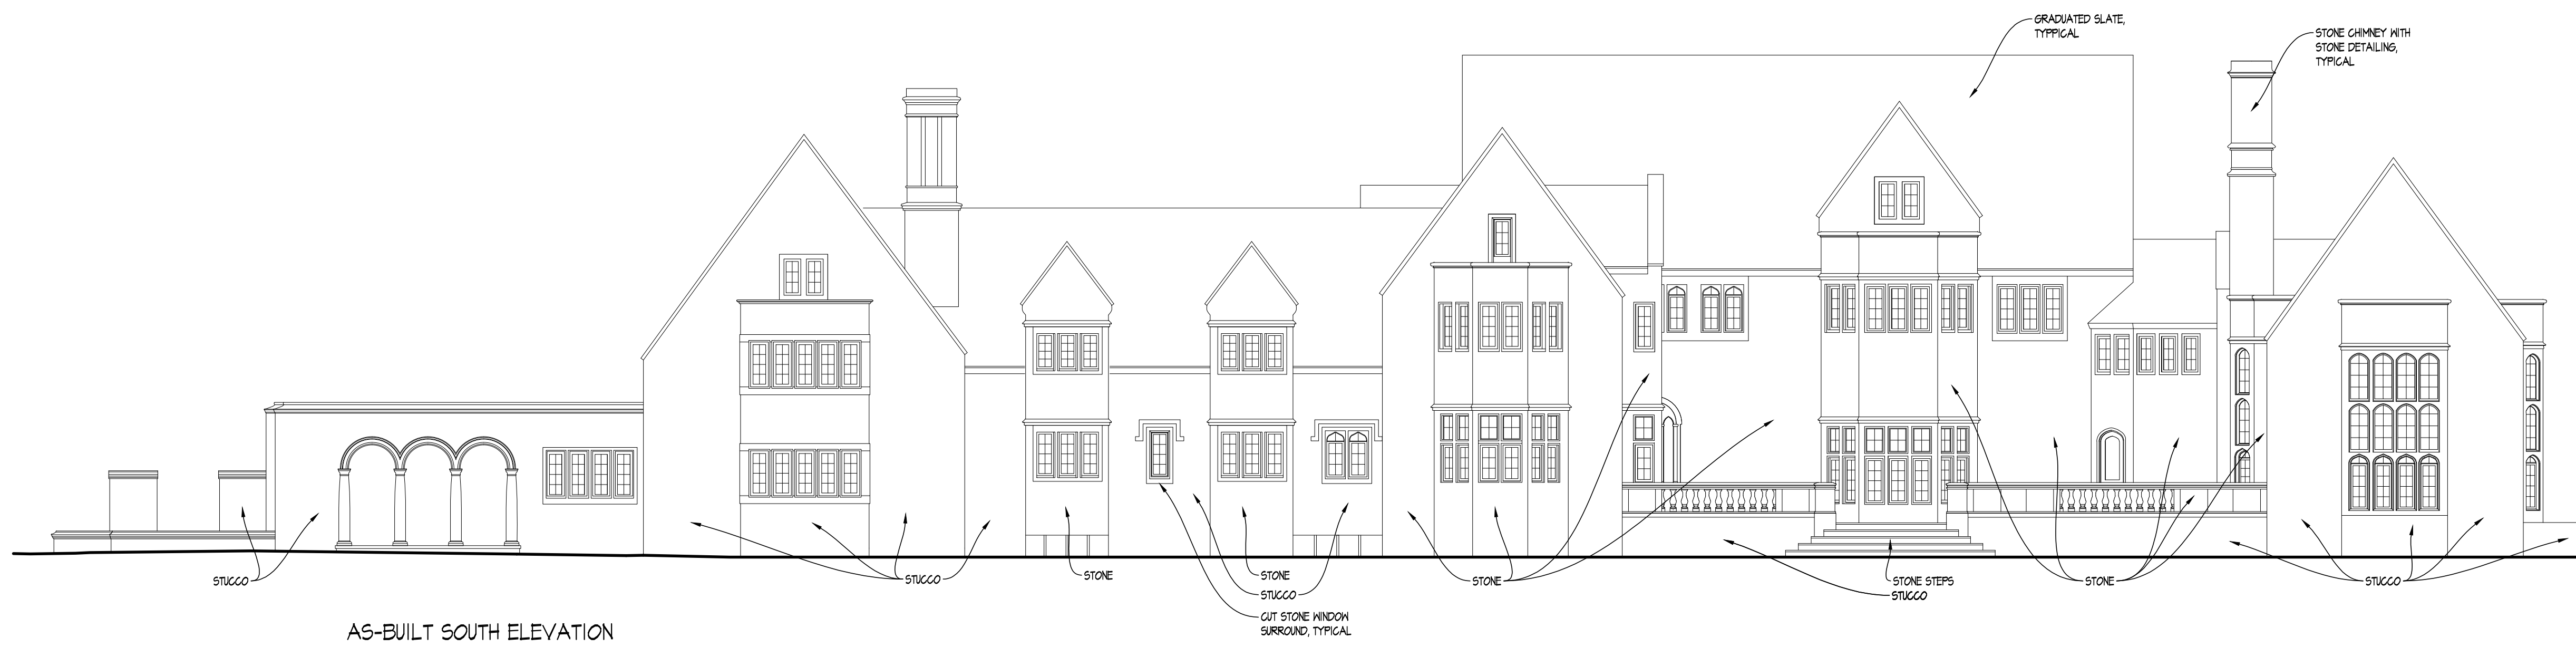

AS-BUILT SOUTH ELEVATION  
SCALE: 1/8" = 1'-0"

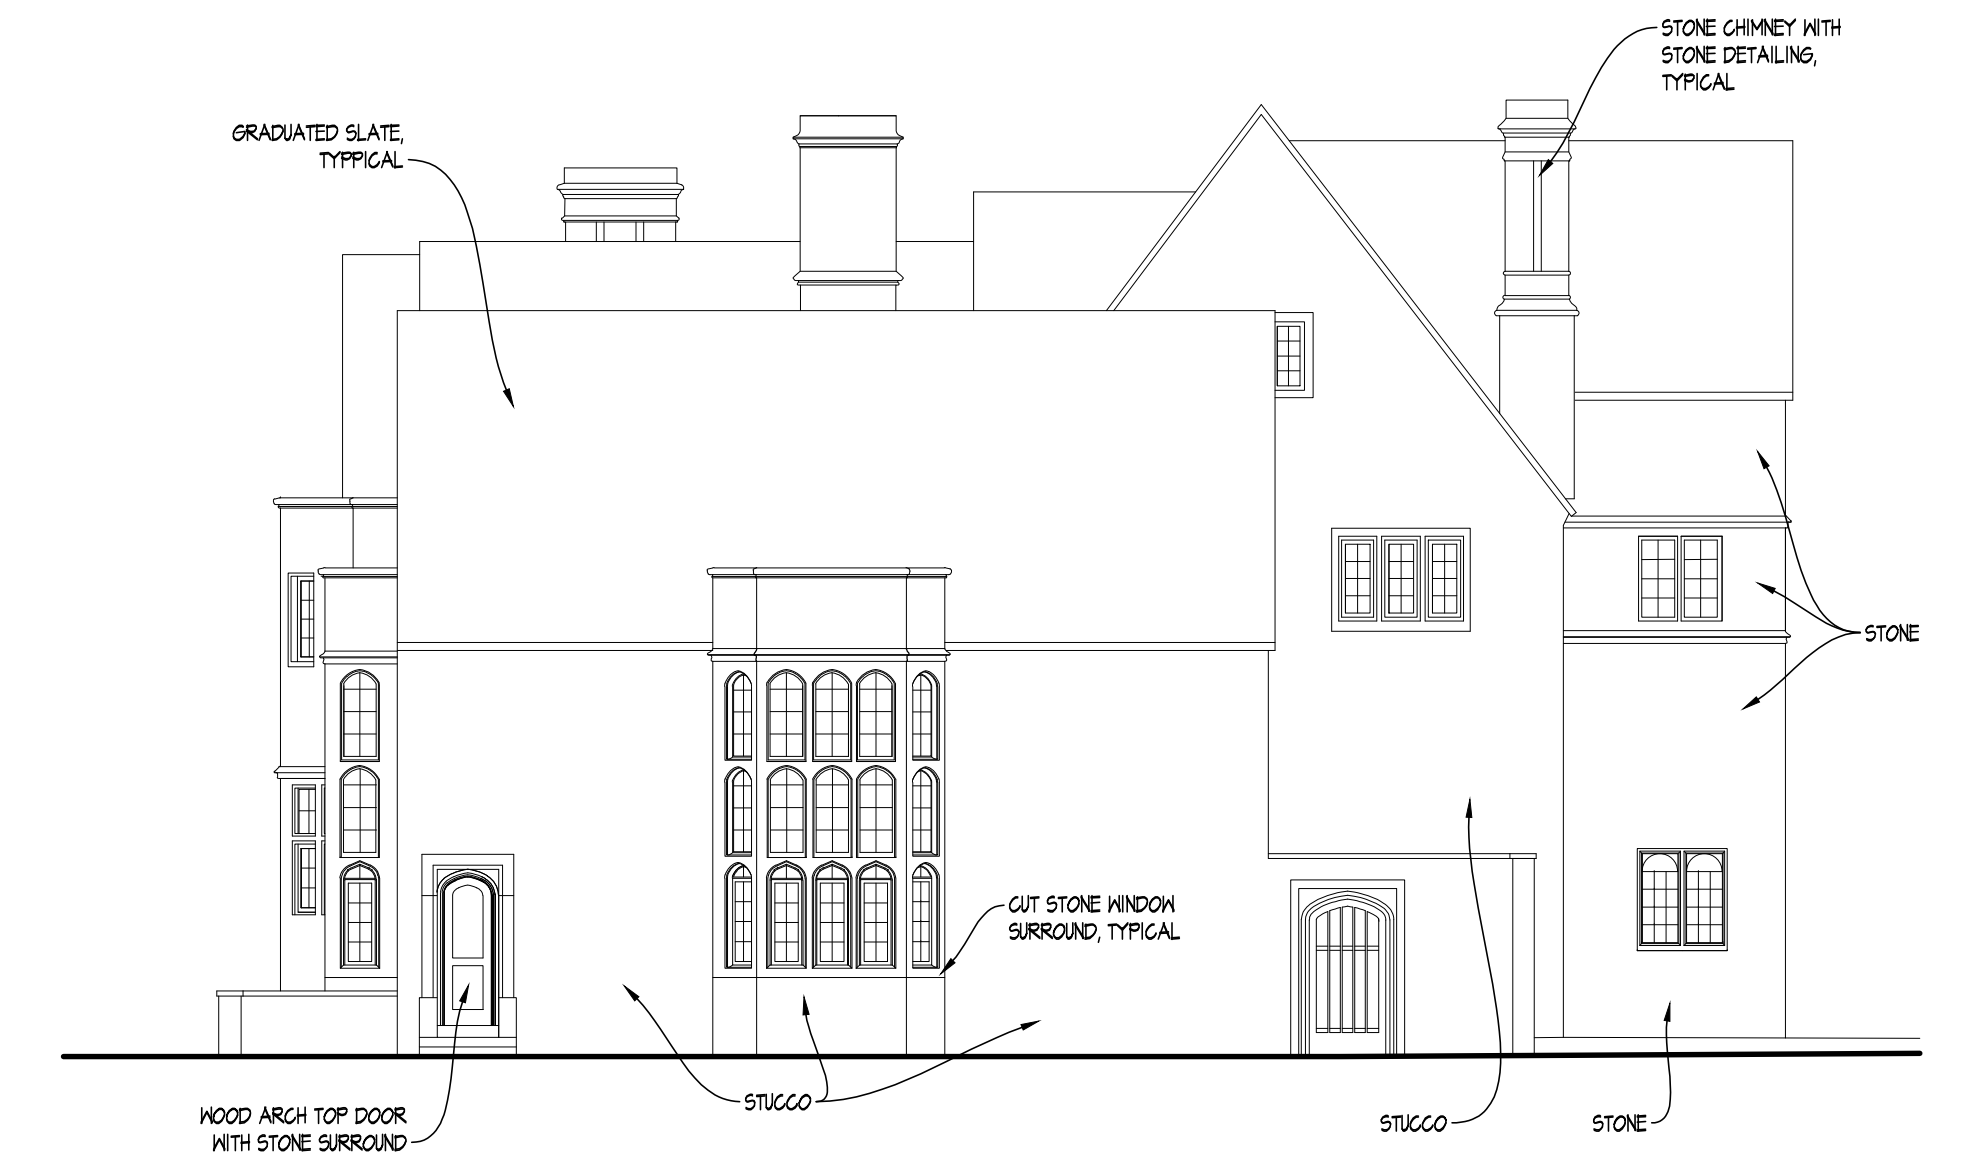


AS-BUILT EAST ELEVATION  
SCALE: 1/8" = 1'-0"



PROPOSED NORTH ELEVATION  
 SCALE: 1/8" = 1'-0"




PROPOSED WEST ELEVATION  
 SCALE: 1/8" = 1'-0" FROM DRIVEWAY

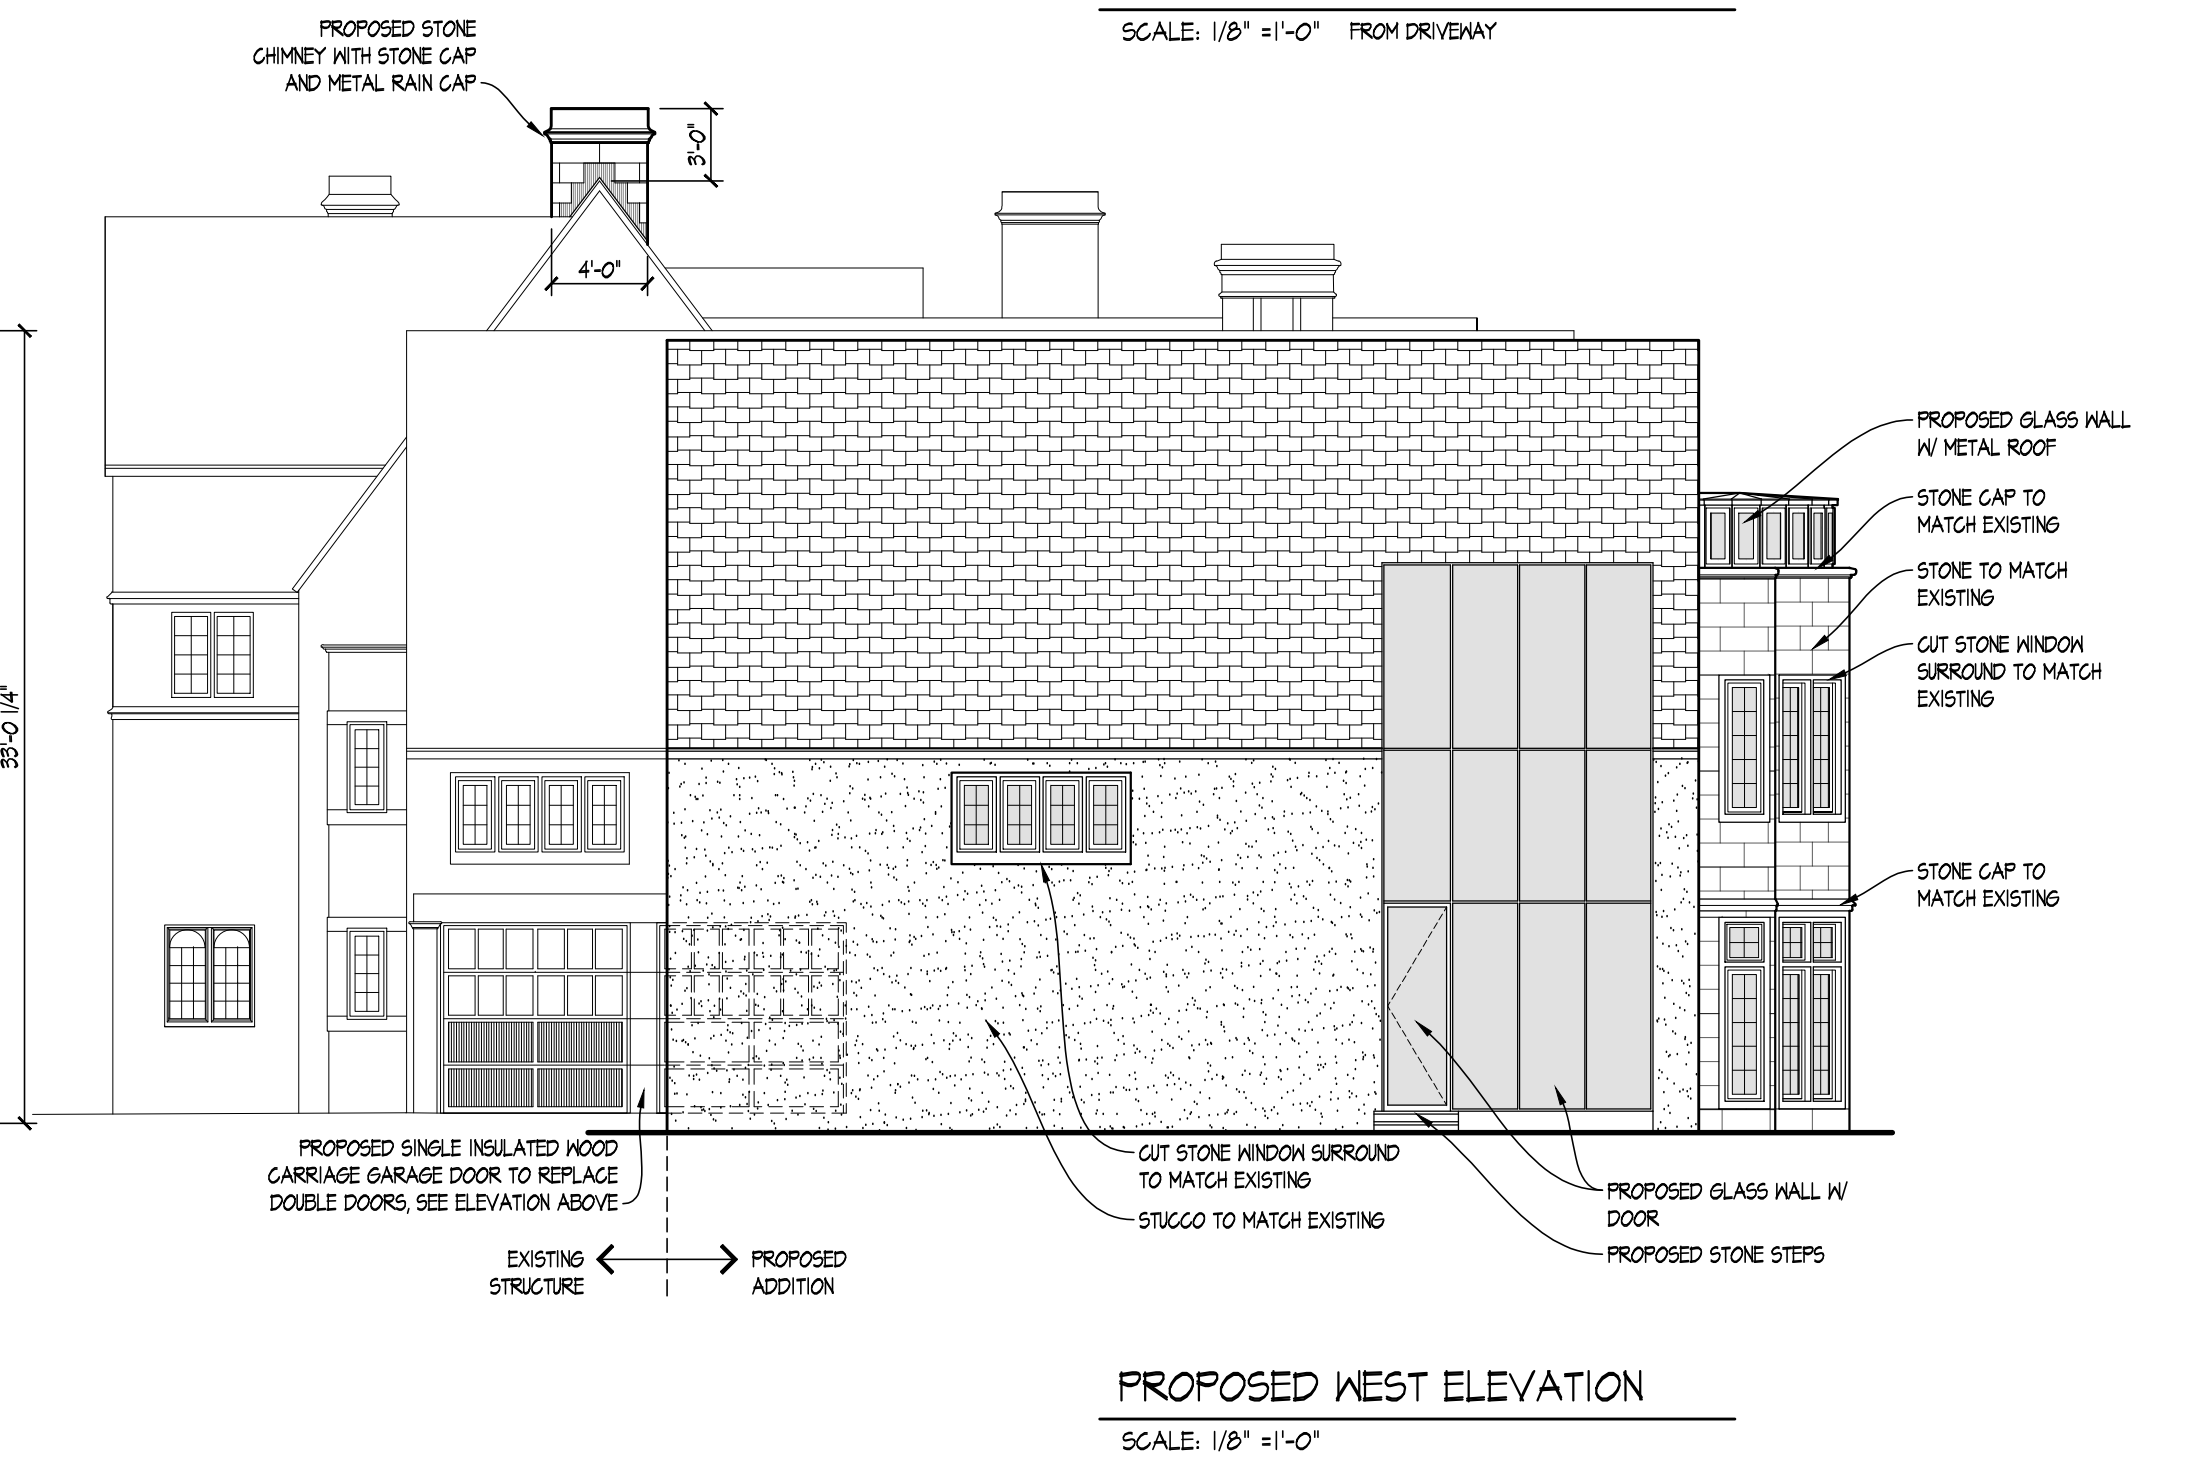

PROPOSED WEST ELEVATION  
 SCALE: 1/8" = 1'-0"



PROPOSED SOUTH ELEVATION  
 SCALE: 1/8" = 1'-0"

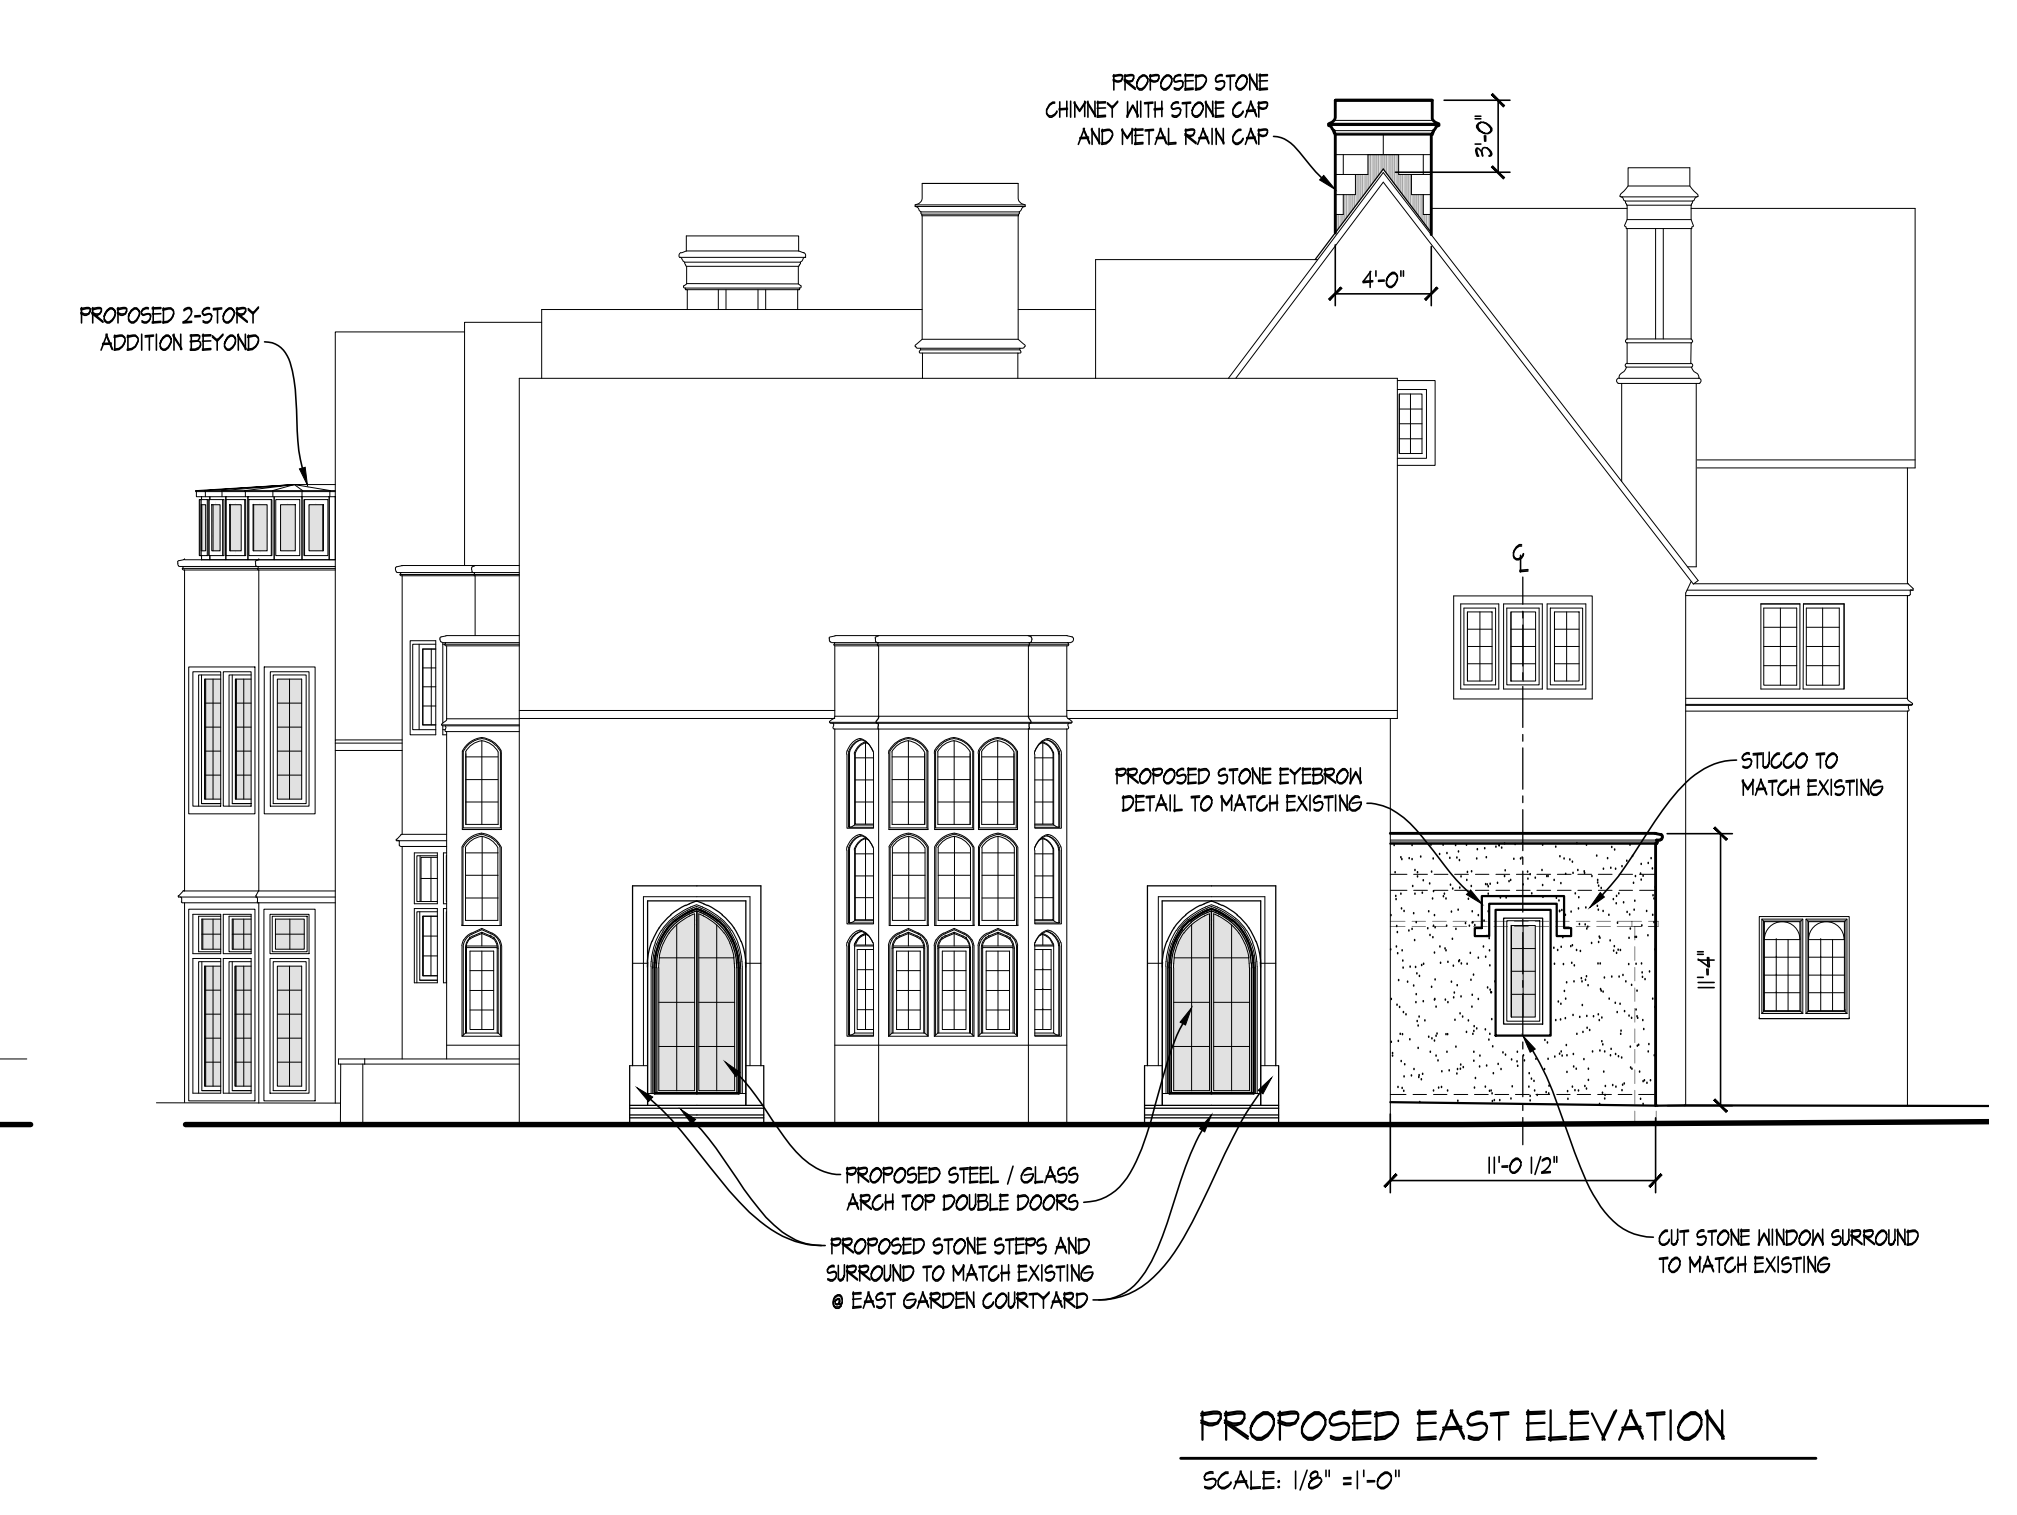

PROPOSED EAST ELEVATION  
 SCALE: 1/8" = 1'-0"