

EXISTING SHADE TREE TO REMAIN

EVERGREEN SCREENING SHRUBS TO BE 24" IN HEIGHT AT TIME OF PLANTING, AND MAINTAINED AT THAT HEIGHT OR GREATER. PROVIDED BY OWNER.

RECOMMEND: TAXUS YEW HEDGES TO MATCH EXISTING

EXISTING STREET TREE TO REMAIN

EXISTING AT&T TELECOM BOXES TO REMAIN

EXISTING SHADE TREES TO REMAIN

N. CASSADY AVE.

EXISTING STREET TREE TO REMAIN

SHADE TREE TO HAVE MINIMUM 2" CALIPER AT TIME OF PLANTING. PROVIDED BY OWNER.

RECOMMEND: CELESTIAL FLOWERING DOGWOOD CORNUS 'RUTDAN'


MULCH BED TO WRAP ORNAMENTAL GRASS AND TO CONTINUE THE LENGTH OF THE SCREENING SHRUBS.

SHADE TREE TO HAVE MINIMUM 2" CALIPER AT TIME OF PLANTING. PROVIDED BY OWNER.

RECOMMEND: ROBINSON FLOWERING CRAB* MALUS 'ROBINSON'

AREA INDICATES SMALL ORNAMENTAL GRASSES SILVERY SUNPROOF LIRIOPE OR APPROVED EQUAL

HANDICAP SIGNAGE SEE 2/A0.1

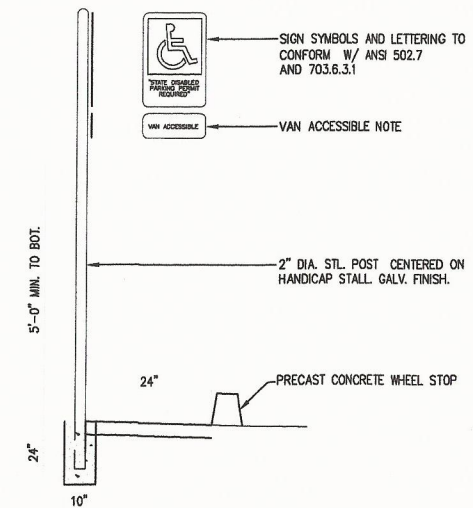

2 HANDICAP SIGN DETAIL
SCALE: 3/4" = 1'-0"

24"x24" PORCELAIN TILE PAVERS, COLOR TO BE SILVER QUARTZ. PRODUCT PROVIDED BY TENANT.

CONTEMPORARY WOOD PLANTER, TYP. PROVIDED BY TENANT.

CONTEMPORARY CONCRETE PLANTER, TYP. PROVIDED BY TENANT.

DECORATIVE PLANTING GRASS, TYPICAL ALL PLANTERS PROVIDED BY TENANT.

RECOMMEND: HORSETAIL GRASS EQUISETUM HYEMALE

SHADE TREE TO HAVE MINIMUM 2" CALIPER AT TIME OF PLANTING. PROVIDED BY OWNER.

RECOMMEND: ROBINSON FLOWERING CRAB* MALUS 'ROBINSON'

SHADE TREE TO HAVE MINIMUM 2" CALIPER AT TIME OF PLANTING. PROVIDED BY OWNER.

RECOMMEND: CELESTIAL FLOWERING DOGWOOD CORNUS 'RUTDAN'

EVERGREEN SCREENING SHRUBS TO BE 24" IN HEIGHT AT TIME OF PLANTING, AND MAINTAINED AT THAT HEIGHT OR GREATER. PROVIDED BY OWNER.

RECOMMEND: TAXUS YEW HEDGES TO MATCH EXISTING

Not doing weeds

No Linings in front of sign + very sparse by plants (21)

Concrete base not removed, just covered by mulch


Dead Replace

1 SITE PLAN
SCALE: 1:10

7.18.19

No.	Date	Revisions
2	11-7-18	TENANT REV


SE-RA ARCHITECTURE

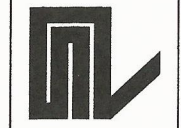

Joaquin Sorrentino, AIA, NCARB
SE-RA Architecture, LLC
33 East Oakland Avenue
Columbus, Ohio 43201
Copyright, 2018
SE-RA Architecture, LLC

Job No.	2018-00-09	Permit	10/02/18	SH	JS
Set No.		Date:		Drawn by:	Checked by:

bluespot YOGA
396 North Cassady Avenue, Bayley Ohio 43209
Proposed Site Plan

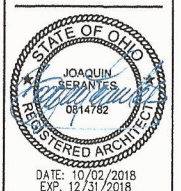

DATE: 10/02/2018
EXP: 12/31/2018

A0.1