JULIET BULLOCK ARCHITECTS
1182 WYANDOTTE RD
COLUMBUS OH 43212
614-935-0944

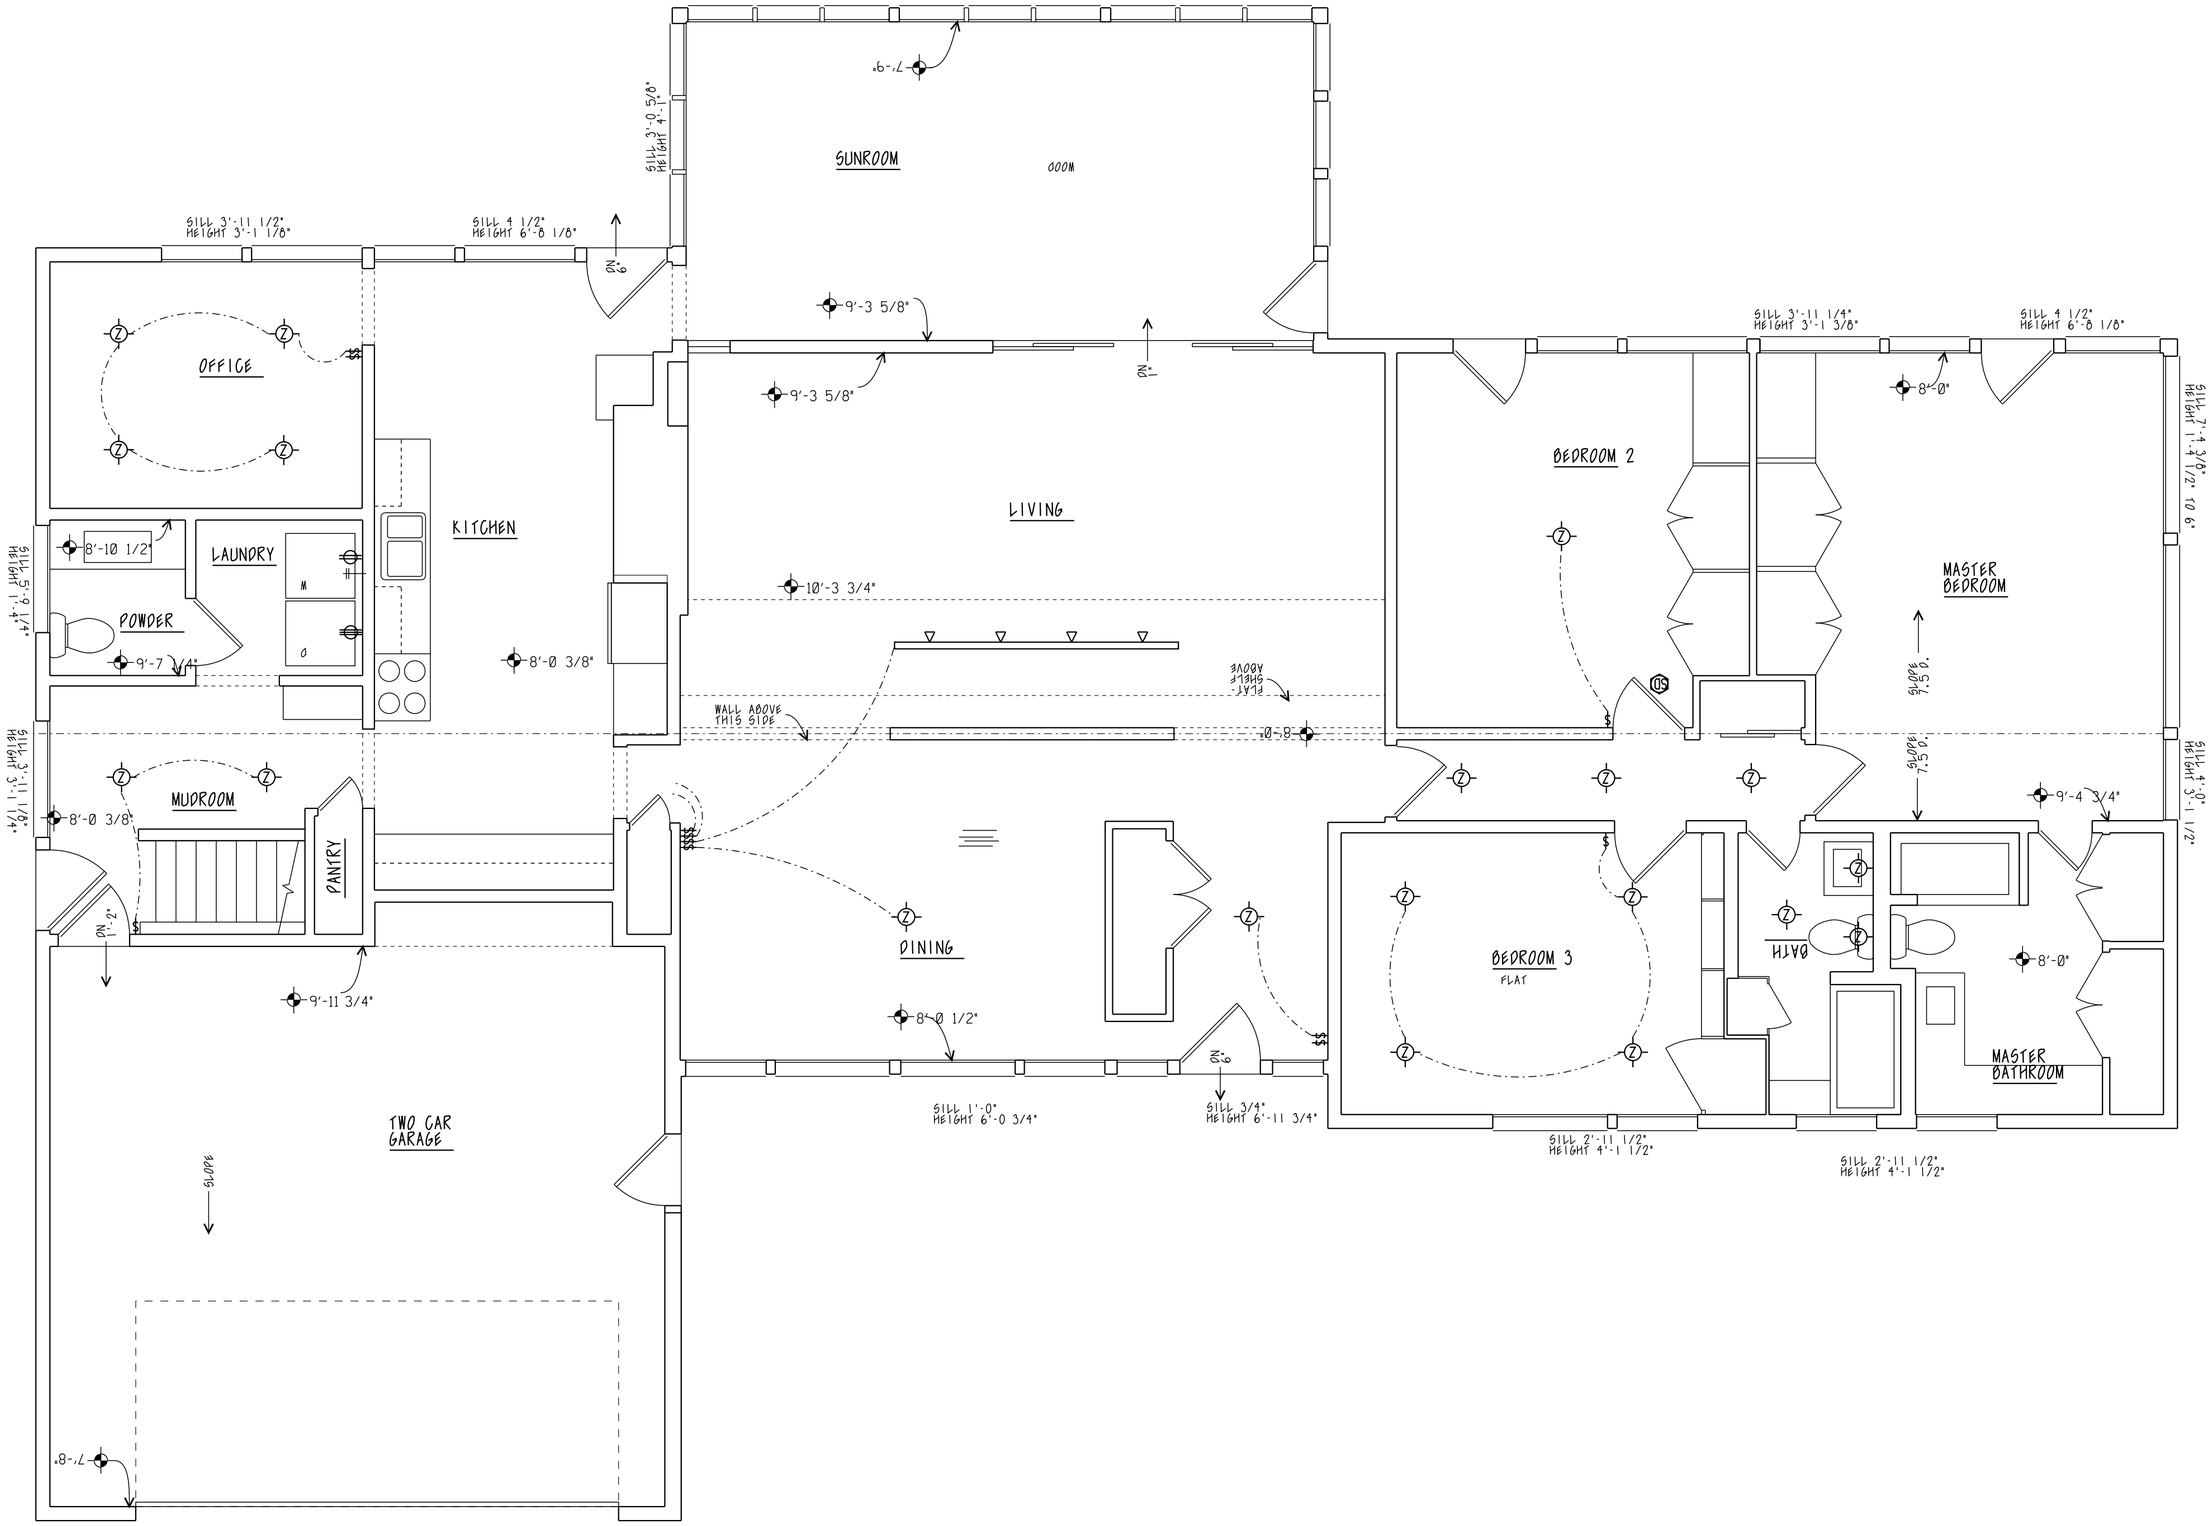

ASBUILT
FIRST FLOOR PLAN

SCALE: 1/4" = 1'-0"

NORTH

5/14/18

DEPEW RESIDENCE
476 N PARKVIEW AVENUE
COLUMBUS OHIO

SHEET 2